

LEE

MISSISSIPPI BOARD OF WATER COMMISSIONERS

39  
5-8-62

WATER WELL DRILLERS LOG

Date: May 8, 1962, Driller: HERNDON WELL & SUPPLY CO. County: Lee

P. O. BOX 42

SHANNON, MISSISSIPPI

(1) Owner of Land:	Description & Color of Materials	Thick-ness Feet	Depth Feet
Herchel Reynolds (Name) Rt 2 Shannon, Miss (Address)	Surface sand & clay		0
(2) Location: 1/4, 1/4, Sec. 4 T. 11 S. R. 6 E	Thin sand		28
3 miles N E of Shannon (distance) (direction) (Nearest Town)	sand		200
(3) Topography: Flat (Hilly) (Flat) (Level)	Bottom		320
(4) Purpose of Well: Domestic (Domestic Irrigation, Municipal, Industrial, Other)			

Information upon completion of well:



- (1) Diameter: 4 inches.
- (2) Total Depth: 320 feet.
- (3) Water Level: 80 feet below top of ground.
- (4) Cased to: 30' 1", Size: 4"
- (5) Screen: Size: Length:
- (6) Were any formations sealed against pollution?  
yes, no.

If YES depth of formation: 28 ft.

Why: Surface & sand

Drillers Remarks:

283 ELEV 282

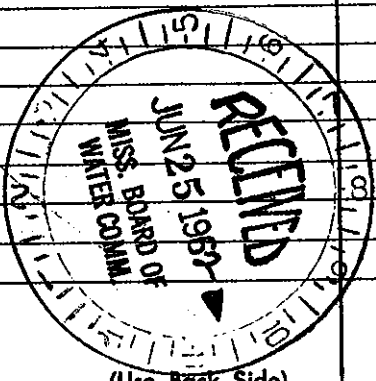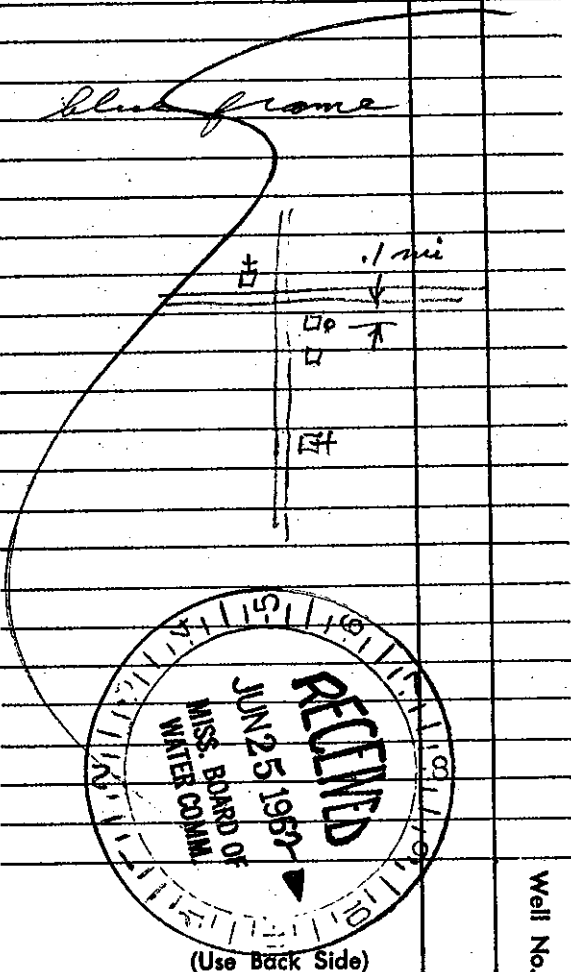

Well No.

Mail this copy to Board of Water Commissioners 429 Miss. St. Jackson, Miss