

LEE  
D40

MISSISSIPPI BOARD OF WATER COMMISSIONERS

WATER WELL DRILLERS LOG

9-10-62

Date: Sept 10, 1962, Driller: HERNDON WELL & SUPPLY CO County Lee

M.E. KELLUM P. BOX 42  
SHANNON, MISSISSIPPI

(1) Owner of Land:	Description & Color of Materials Sand, Clay, Red Clay, Shell, etc.	Thick- ness Feet	Depth Feet
<u>Maria Kellum</u> (Name)	<u>uniform sand</u>		<u>0</u>
<u>Rt 2 Shannon, Miss.</u> (Address)	<u>&amp; clay</u>		<u>25</u>
(2) Location: <u>1/4</u> , <u>1/4</u> , Sec. <u>8</u> T. <u>15</u> R. <u>15</u>			
<u>3</u> miles <u>N.E.</u> , of <u>Shannon</u> (distance) (direction) (Nearest Town)	<u>Blue rock</u>		
(3) Topography: <u>Flat</u> (Hilly) (Flat) (Level)	<u>sand</u>		<u>180</u>
(4) Purpose of Well: <u>Domestic</u> (Domestic Irrigation, Municipal, Industrial, Other)	<u>Bottom</u>		<u>300</u>

Information upon completion of well:



- (1) Diameter 4 inches.
- (2) Total Depth 300 feet.
- (3) Water Level 60 feet below top of ground.
- (4) Cased to 30 ft, Size 4"
- (5) Screen: Size —, Length —
- (6) Were any formations sealed against pollution?  
 yes,  no.

If YES depth of formation 28 ft.

Why Uniform & sand

Drillers Remarks:

290 ELEV 272

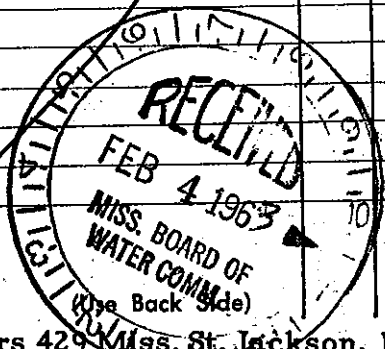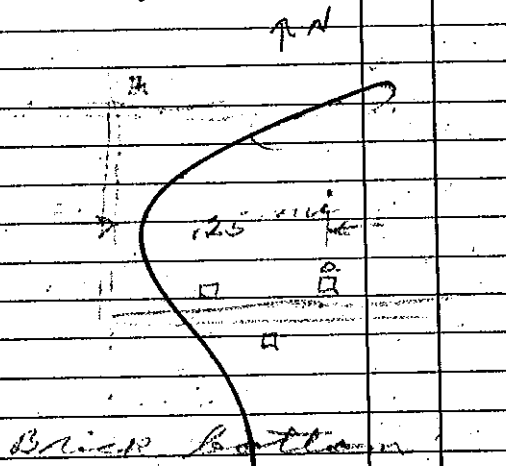

Well No.