

LEE
04/
9-14-62

MISSISSIPPI BOARD OF WATER COMMISSIONERS

WATER WELL DRILLERS LOG

HERNDON WELL & SUPPLY CO.

P. O. BOX 42
SHANNON, MISSISSIPPI

Date: Sept 14, 1962, Driller: _____

County Lee

(1) Owner of Land: Johnny Dye
(Name)

Rt 2 Shannon, Miss
(Address)

(2) Location: $\frac{1}{4}$, $\frac{1}{4}$, Sec. 9 T 11S R 6E

2 miles NE, of Shannon
(distance) (direction) (Nearest Town)

(3) Topography: Flat
(Hilly) (Flat) (Level)

(4) Purpose of Well: Domestic
(Domestic Irrigation, Municipal, Industrial, Other)

Description & Color of Materials
Sand, Clay, Red Clay, Shell, etc.

Thick-
ness
Feet

Depth
Feet

| | | |
|---------------------|--|-----|
| Surface sand & clay | | 0 |
| Blue rock | | 15 |
| Hard rock | | 50 |
| Blue rock | | 65 |
| sand | | 180 |
| Bottom | | 300 |

Information upon completion of well:

(1) Diameter 4 inches.

(2) Total Depth 300 feet.

(3) Water Level 40 ft feet below top of ground.

(4) Cased to 21 ft Size 4"

(5) Screen: Size _____, Length _____



(6) Were any formations sealed against pollution?

yes, no.

If YES depth of formation 15

Why Surface & sand

Drillers Remarks: _____

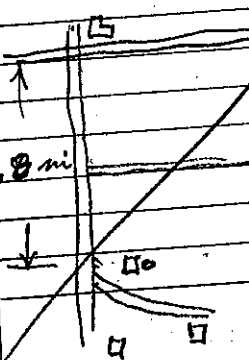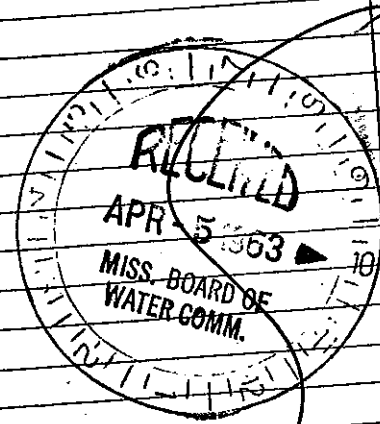

P1 ELEV 252

(Use Back Side)

Well No.

this copy to Board of Water Commissioners 429 Miss. St. Jackson, Miss