

LEE  
 047  
 9-8-62

MISSISSIPPI BOARD OF WATER COMMISSIONERS

WATER WELL DRILLERS LOG

HERNDON WELL & SUPPLY CO.

Date: Sept 8, 1962, Driller: HERNDON, P. O. BOX 42, County LEE, MISSISSIPPI

	Description & Color of Materials Sand, Clay, Red Clay, Shell, etc.	Thick- ness Feet	Depth Feet
(1) Owner of Land: <u>Ralph Vest</u> (Name)	<u>Surface sand</u>		<u>0</u>
At <u>2 Shannon, Miss</u> (Address)	<u>&amp; clay</u>		
(2) Location: <u>6 1/2</u> Sec. <u>15</u> T. <u>15</u> R. <u>6 E</u>	<u>Blue rock</u>		<u>20</u>
<u>2 1/2</u> miles <u>NE</u> of <u>Shannon</u> (distance) (direction) (Nearest Town)	<u>sand</u>		<u>100</u>
(3) Topography: <u>Flat</u> (Hilly) (Flat) (Level)	<u>Bottom</u>		<u>340</u>
(4) Purpose of Well: <u>Domestic</u> (Domestic Irrigation Municipal, Industrial, Other)			


Information upon completion of well:

- (1) Diameter 5 inches.
- (2) Total Depth 340 feet.
- (3) Water Level 50 feet below top of ground.
- (4) Cased to 23'7", Size 5"
- (5) Screen: Size     , Length
- (6) Were any formations sealed against pollution?  
 yes,  no.

If YES depth of formation 20 ft

Why Surface sand

Drillers Remarks:

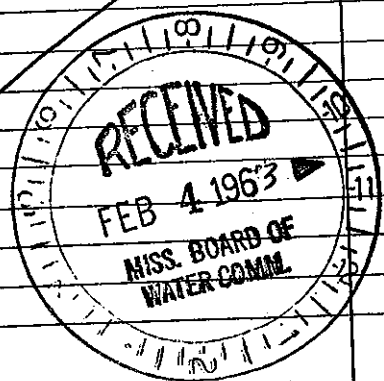

789 ELEV 270

(Use Back Side)

Well No.

Mail this copy to Board of Water Commissioners 429 Miss. St. Jackson, Miss