

LEE MISSISSIPPI BOARD OF WATER COMMISSIONERS

044

10-23-65

WATER WELL DRILLERS LOG

Hendon-Horsan Well Supply, Inc.

Date Oct. 23, 1963, Driller: SHANNON P. O. Box 42 County Lee  
(Name) MISSISSIPPI 38868

(1) Owner of Land	Description & Color of Materials Sand, Clay, Red Clay, Shell, etc.	Thick- ness Feet	Depth Feet
<u>Mr. Bonnie Tate</u> <small>(Name)</small>	<u>surface sand &amp; clay</u>	0 -	20
<u>At 2 Shannon, Miss</u> <small>(Address)</small>	<u>blue clay</u>	20 -	220
(2) Location: <u>1/4, 1/4, Sec. 4 T. 11 S. R. 6 E</u>	<u>sand</u>	220 -	330
<u>3</u> miles <u>NE</u> of <u>Shannon</u> <small>(distance) (direction) (Nearest Town)</small>	<u>Bottom</u>		340
(3) Topography: <u>Hilly</u> <small>(Hilly) (Flat) (Level)</small>			
(4) Purpose of Well: <u>Domestic</u> <small>(Domestic Irrigation Municipal, Industrial, Other)</small>			


Information upon completion of well:

- (1) Diameter 4 inches.
- (2) Total Depth 340 feet.
- (3) Water Level 80 feet below top of ground.
- (4) Cased to 25', Size 4"
- (5) Screen: Size     , Length
- (6) Were any formations sealed against pollution?  
 yes,  no.

If YES depth of formation 20'

Why surface & sand

Drillers Remarks:

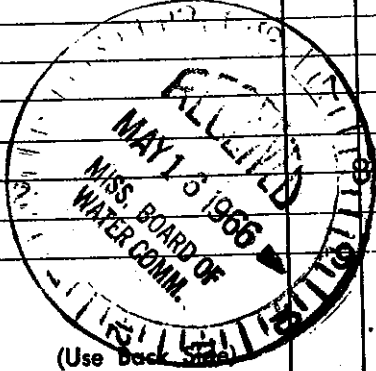

305 ELEV 302

Well No.