

MISSISSIPPI BOARD OF WATER COMMISSIONERS

LEE

QAG

3-26-63

WATER WELL DRILLERS LOG

Date March 26, 1963, Driller: HERNDON WELL & SUPPLY CO County LEE

P. O. BOX 12
SHANNON, MISSISSIPPI

(1) Owner of Land: <u>Condon Muller</u> (Name)	Description & Color of Materials Sand, Clay, Red Clay, Shell, etc.	Thick- ness Feet	Depth Feet
<u>Rt 2 Shannon, Miss</u> (Address)	<u>surface sand</u>		<u>0</u>
(2) Location: <u>1/4, 1/4, Sec. 9 T 15 N R 6 E</u> <u>3 miles N.E.</u> of <u>Shannon</u> (distance) (direction) (Nearest Town)	<u>to blue rock</u>		<u>18</u>
(3) Topography: <u>flat</u> (Hilly) (Flat) (Level)	<u>sand</u>		<u>180</u>
(4) Purpose of Well: <u>Domestic</u> (Domestic Irrigation Municipal, Industrial, Other)	<u>Bottom</u>		<u>300</u>


Information upon completion of well:

- (1) Diameter 4 inches.
- (2) Total Depth 300 feet.
- (3) Water Level 33 feet below top of ground.
- (4) Cased to 21', Size 4"
- (5) Screen: Size —, Length —
- (6) Were any formations sealed against pollution?
yes, no.

If YES depth of formation 15 ft.

Why surface & sand

Drillers Remarks:

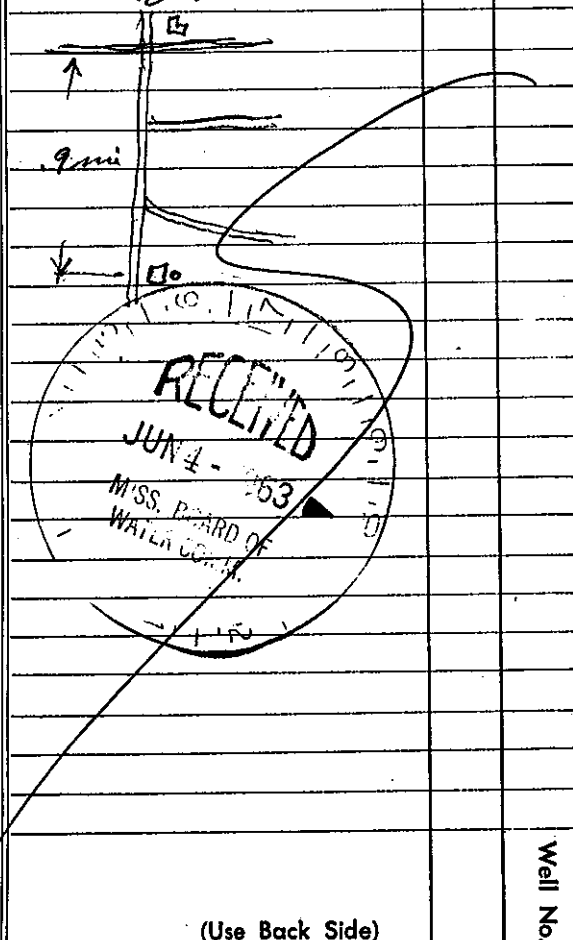

299 ELEV 245

(Use Back Side)

Well No.

Mail this copy to Board of Water Commissioners 429 Miss. St. Jackson, Miss