

LEE

MISSISSIPPI BOARD OF WATER COMMISSIONERS

047  
5-23-63

WATER WELL DRILLERS LOG

Date: 5/23, 1963, Driller: HERNDON WELL & SUPPLY CO. P. O. BOX 42 County Lee  
SHANNON, MISSISSIPPI


(1) Owner of Land	Description & Color of Materials Sand, Clay, Red Clay, Shell, etc.	Thick- ness Feet	Depth Feet
Ralph Patterson (Name) Rt 2 Shannon, Miss. (Address)	surface sand & clay	8	0
(2) Location: 1/4, 1/4, Sec. 20 T. 11 S. R. 6 E 1 miles E of Shannon (distance) (direction) (Nearest Town)	blue sand & sand	8	20 120
(3) Topography: flat (Hilly) (Flat) (Level)	8		
(4) Purpose of Well: Domestic (Domestic Irrigation, Municipal, Industrial, Other)	Bottom	320	320

Information upon completion of well:

- (1) Diameter 4 inches.
- (2) Total Depth 320 feet.
- (3) Water Level 45 feet below top of ground.
- (4) Cased to 24' 9" Size 4"
- (5) Screen: Size —, Length —
- (6) Were any formations sealed against pollution?  
yes, no.
- If YES depth of formation 20

Why surface & sand

Drillers Remarks:

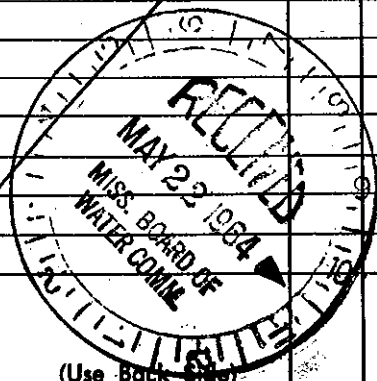

(Use Back Side)

Well No.

298 ELEV 295

Mail this copy to Board of Water Commissioners 429 Miss. St. Jackson, Miss.