

LEE

MISSISSIPPI BOARD OF WATER COMMISSIONERS

① 98  
6-17-61

WATER WELL DRILLERS LOG

0309

Date: June 17, 1961, Driller: HERNDON WELL & SUPPLY CO.  
P. O. BOX 42 County Lee  
SHANNON, MISSISSIPPI

(1) Owner of Land	Description & Color of Materials Sand, Clay, Red Clay, Shell, etc.	Thick- ness Feet	Depth Feet
<u>Clyde Hampton</u> (Name) <u>22 Shannon, Miss</u> (Address)	<u>Surface Sand</u> <u>&amp; clay</u>		<u>0</u>
(2) Location: <u>1/4, 1/4, Sec 20 T 115 R 6 E</u> <u>3/4 miles East of Shannon,</u> (distance) (direction) (Nearest Town)	<u>Blue rock</u> <u>Sand</u>	<u>18</u> <u>8</u>	<u>18</u> <u>200</u>
(3) Topography: <u>Flat</u> (Hilly) (Flat) (Level)	<u>Bottom</u>	<u>320</u>	
(4) Purpose of Well: <u>Domestic</u> (Domestic Irrigation Municipal, Industrial, Other)			



Information upon completion of well:

- (1) Diameter 4 inches.
- (2) Total Depth 320 feet.
- (3) Water Level 65 feet below top of ground.
- (4) Cased to 22', Size 4"
- (5) Screen: Size     , Length
- (6) Were any formations sealed against pollution?  
✓ yes,      no.

If YES depth of formation 18'

Why Surface & Sand

Drillers Remarks:

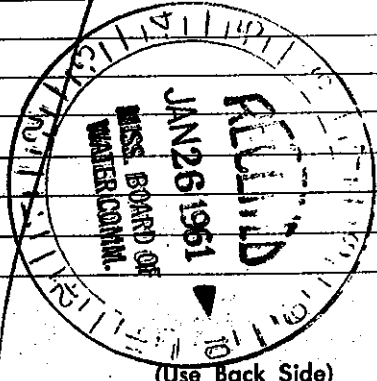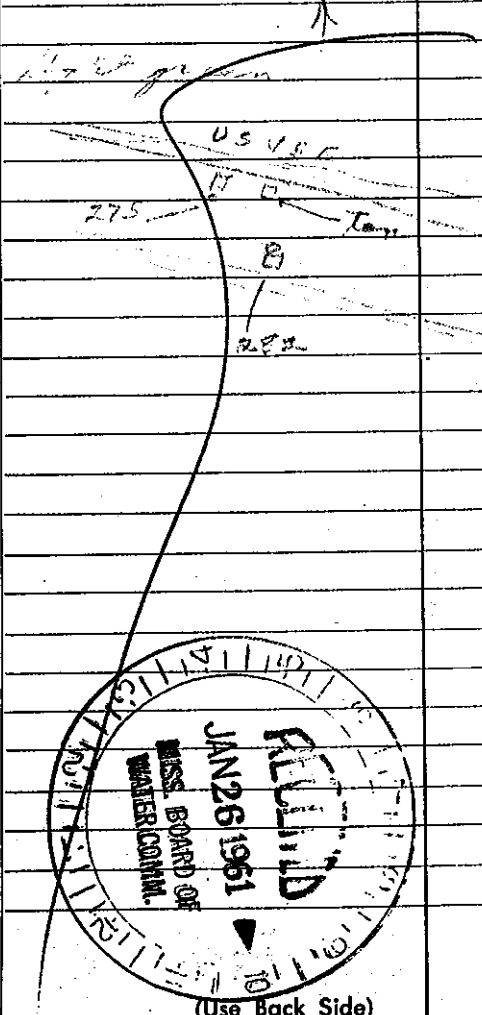

(Use Back Side)

Well No.

275 ELEV 265

Mail this copy to Board of Water Commissioners 429 Miss. St. Jackson, Miss