

LEE

MISSISSIPPI BOARD OF WATER COMMISSIONERS

049  
3-19-62

WATER WELL DRILLERS LOG

Date: March 15, 1962, Driller: HERNDON WELL & SUPPLY CO, Lee County, Miss.  
P. O. BOX 42  
SHANNON, MISSISSIPPI

(1) Owner of Land	Description & Color of Materials Sand, Clay, Red Clay, Shell, etc.	Thick- ness Feet	Depth Feet
<u>James Garret</u> (Name) <u>Shannon, Miss.</u> (Address)	<u>Surface sand</u> <u>&amp; clay</u>		<u>0</u>
(2) Location: <u>1/4</u> , <u>1/4</u> , Sec <u>20</u> T <u>11 S</u> R <u>6 E</u> <u>1/2</u> miles <u>E</u> , of <u>Shannon</u> (distance) (direction) (Nearest Town)	<u>Blue rock</u> <u>to</u> <u>sand</u> <u>to</u>		<u>15'</u>  <u>200</u>
(3) Topography: <u>Flat</u> (Hilly) (Flat) (Level)			
(4) Purpose of Well: <u>Domestic</u> (Domestic Irrigation Municipal, Industrial, Other)	<u>Bottom</u>		<u>320</u>


Information upon completion of well:

- (1) Diameter 4 inches.
- (2) Total Depth 320 feet.
- (3) Water Level 50 feet below top of ground.
- (4) Cased to 18 3/4" Size 4
- (5) Screen: Size \_\_\_\_\_, Length \_\_\_\_\_
- (6) Were any formations sealed against pollution?  
 yes, \_\_\_\_\_ no.

If YES depth of formation Surface Sand

Why \_\_\_\_\_

Drillers Remarks: \_\_\_\_\_

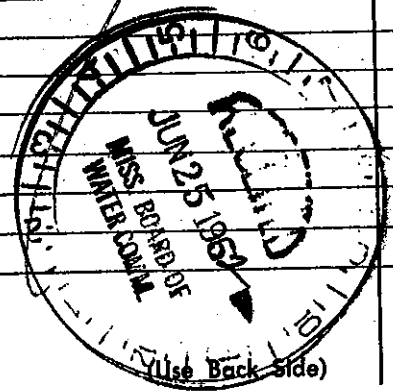

Well No.

282 FILED 262

Mail this copy to Board of Water Commissioners 429 Miss. St. Jackson, Miss.