

LEE

MISSISSIPPI

OF WATER COMMISSIONERS

① 50

WATER WELL DRILLERS LOG

6-28-62

Date: Jun 28 1962, Driller: HERNDON WELL & SUPPLY CO. County: Lee

P. O. BOX 42
SHANNON, MISSISSIPPI

(1) Owner of Land:	Description & Color of Materials Sand, Clay, Red Clay, Shell, etc.	Thick- ness Feet	Depth Feet
Name: <u>J. F. Gauthier</u>			
Address: <u>Rt 2 Shannon, Miss</u>	<u>surface sand</u>		<u>0</u>
(2) Location: $\frac{1}{4}$, $\frac{1}{4}$, Sec. <u>28</u> T. <u>11</u> R. <u>6E</u>	<u>clay</u>		
<u>2 1/2</u> miles <u>E</u> , of <u>Shannon</u> (distance) (direction) (Nearest Town)	<u>Blue ark</u>	<u>20</u>	
(3) Topography: <u>Flat</u> (Hilly) (Flat) (Level)	<u>sand</u>	<u>150</u>	
(4) Purpose of Well: <u>Domestic</u> (Domestic Irrigation Municipal, Industrial, Other)	<u>Bottom</u>	<u>300</u>	


Information upon completion of well:

- (1) Diameter 5 inches.
- (2) Total Depth 300 feet.
- (3) Water Level 40 feet below top of ground.
- (4) Cased to 25', Size 5".
- (5) Screen: Size —, Length —.
- (6) Were any formations sealed against pollution?
 yes, no.

If YES depth of formation 20'

Why surface sand

Drillers Remarks: jet pump

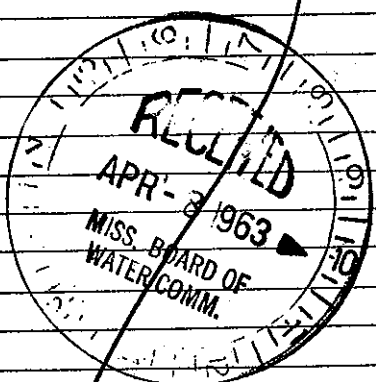

285 ELEV 265

(Use Back Side)

Well No.

Mail this copy to Board of Water Commissioners 429 Miss. St. Jackson, Miss