

LEE

MISSISSIPPI BOARD OF WATER COMMISSIONERS

051

64
8-23-63

WATER WELL DRILLERS LOG

Date: 8/23, 1964, Driller: WERNDON WELL & SUPPLY CO. County: Lee

P.O. BOX 42
SHANNON, MISSISSIPPI

(1) Owner of Land:	Description & Color of Materials Sand, Clay, Red Clay, Shell, etc.	Thick- ness Feet	Depth Feet
T. T. Brubaker (Name)	surface sand		0
At 2 Shannon, Miss. (Address)	& clay		
(2) Location: 1/4, 1/4, Sec 21 T 115 R 6E	Blue sand		20
1 miles E of Shannon (distance) (direction) (Nearest Town)	Sand		190
(3) Topography: Flat (Hilly) (Flat) (Level)	Bottom		320
(4) Purpose of Well: Domestic (Domestic Irrigation Municipal, Industrial, Other)			

Information upon completion of well:


- (1) Diameter 5 inches.
- (2) Total Depth 320 feet.
- (3) Water Level 60 feet below top of ground.
- (4) Cased to 22' 2", Size 5"
- (5) Screen: Size —, Length —
- (6) Were any formations sealed against pollution?
☒ yes, ☐ no.

If YES depth of formation 20'

Why surface & sand

Drillers Remarks:

297 ELEV 270

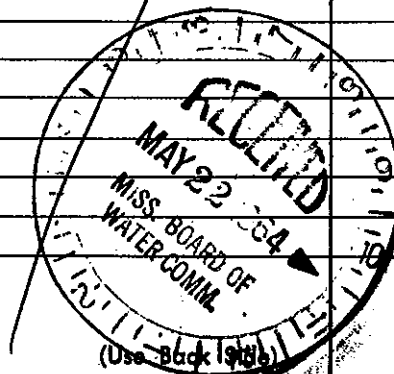

Well No.

Mail this copy to Board of Water Commissioners 429 Miss. St. Jackson, Miss.