

LEE

052

WATER WELL DRILLERS LOG

0?

10-11-60

Herndon Well & Supply Co.

Date: Oct 11, 1960, Driller: SHANNON, MISS. County: Lawrence

(Name)
E.L. LINDSEY (1967)

(1) Owner of Land: Frazier Hall
(Name)
at 1 Plantersville
(Address)
2
(2) Location: 1/4, 1/4, Sec 2, T11R6E
7 miles North W of Nettleton
(distance) (direction) (Nearest Town)
(3) Topography: Flat
(Hilly) (Flat) (Level)
(4) Purpose of Well: Home use
(Domestic Irrigation, Municipal, Industrial, Other)



Description & Color of Materials Sand, Clay, Red Clay, Shell, etc.	Thick- ness Feet	Depth Feet
<u>Sand & clay</u>		
<u>to</u>		<u>18</u>
<u>Blue Rock</u>		
<u>to</u>		
<u>Sand</u>		<u>147</u>
<u>to</u>		
<u>Bottom</u>		<u>252</u>

Information upon completion of well:

(1) Diameter 4 inches.
(2) Total Depth 252 feet.
(3) Water Level 60 feet below top of ground.
(4) Cased to 20'4", Size 4"
(5) Screen: Size —, Length —
(6) Were any formations sealed against pollution?
yes, no.

If YES depth of formation 19 ft
Why Surface & Sand

Drillers Remarks:
239 ELEV 280

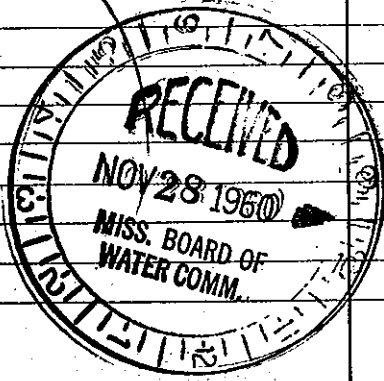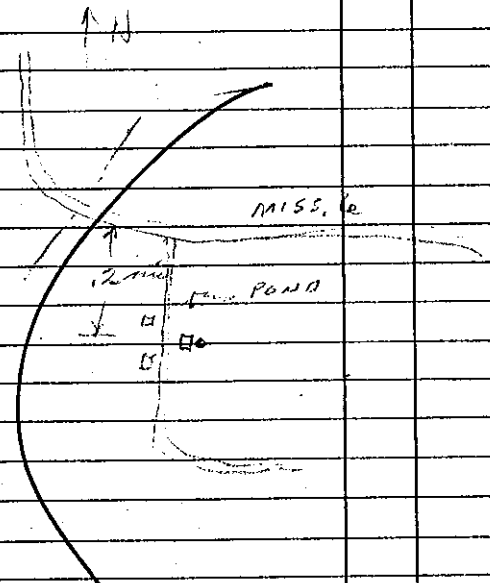

(Use Back Side)

Well No.

Retain this copy for your office files.