

LEE
 2-14-62

MISSISSIPPI BOARD OF WATER COMMISSIONERS

WATER WELL DRILLERS LOG

HERNDON WELL & SUPPLY CO.

Date: 2-14, 1962, Driller: P. O. BOX 42 County Lee

SHANNON, MISSISSIPPI

	Description & Color of Materials Sand, Clay, Red Clay, Shell, etc.	Thick- ness Feet	Depth Feet
(1) Owner of Land: <u>Herald Kullas</u> (Name) <u> Rt 2 SHANNON</u> (Address)	<u>Surface sand</u>		<u>0</u>
(2) Location: <u>1/4, 1/4, Sec 8 T. 115 R. 6E</u> <u>2 miles NE of SHANNON</u> (distance) (direction) (Nearest Town)	<u>clay</u> <u>blue rock</u>	<u>5</u>	<u>17</u>
(3) Topography: <u>Flat</u> (Hilly) (Flat) (Level)	<u>good</u>	<u>5</u>	<u>206</u>
(4) Purpose of Well: <u>Domestic</u> (Domestic Irrigation Municipal, Industrial, Other)	<u>Bottom</u>	<u>320</u>	

Information upon completion of well:



- (1) Diameter 4 inches.
- (2) Total Depth 320 feet.
- (3) Water Level 50 feet below top of ground.
- (4) Cased to 22', Size 4"
- (5) Screen: Size , Length
- (6) Were any formations sealed against pollution?
 yes, no.

If YES depth of formation 20 ft

Why Surface & sand

Drillers Remarks:

210 ELEV 263

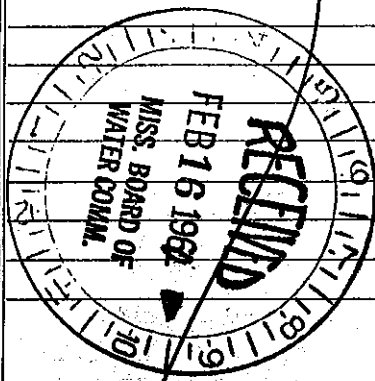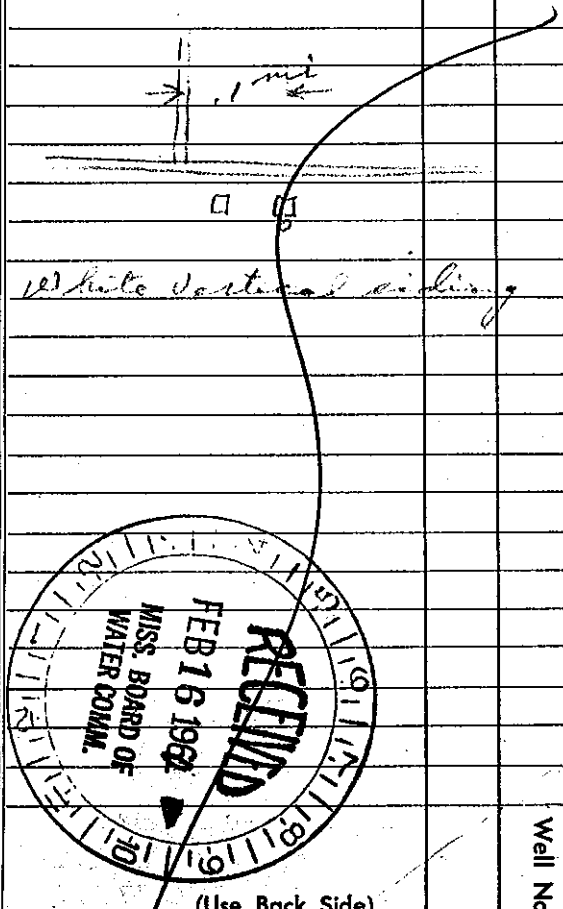

(Use Back Side)

Well No.