

Lee  
061  
5-67

MISSISSIPPI BOARD OF WATER COMMISSIONERS

### WATER WELL DRILLERS LOG

Herndon-Homan Well & Supply, Inc.

Date: 5-8, 1967, Driller: P. O. Box 42 County Lee  
(When well drilled) SHANNON, MISSISSIPPI 38868 (Where well is located)

(1) Owner of Land: Thomas Coggins  
(Name)  
Rt 2 Shannon, Miss.  
(Address)

(2) Location: SW 1/4, NE 1/4, Sec. 5 T15R6E  
2 1/2 miles NE, of Shannon  
(distance) (direction) (Nearest Town)

(3) Topography: Flat  
(Hilly) (Flat) (Level)

(4) Purpose of Well: Home  
(Domestic Irrigation  
Municipal, Industrial, Other)

Description & Color of Materials Sand, Clay, Red Clay, Shell, etc.	Thick- ness Feet	Depth Feet
<u>surface sand &amp; clay</u>	<u>0</u>	<u>18</u>
<u>blue clay</u>	<u>18-240</u>	
<u>sand</u>	<u>940-360</u>	
<u>bottom</u>	<u>360</u>	

#### Information upon completion of well:

(1) Diameter 5 inches.

(2) Total Depth 360 feet.

(3) Water Level 80 feet below top of ground.

(4) Cased to 21' 9", Size 5"

(5) Screen: Size none, Length \_\_\_\_\_

(6) Were any formations sealed against pollution?  
 yes,  no.

If YES depth of formation 18'

Why surface & sand


Drillers Remarks: \_\_\_\_\_

Yield in gpm: 5

Size pump: 1/3 HP Sub

Type power: electric

CODED

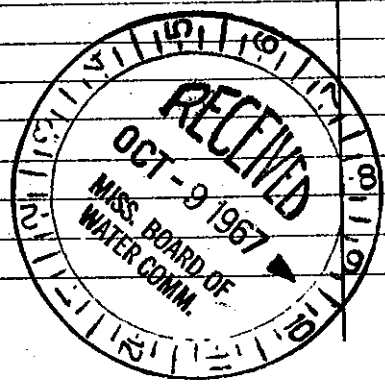

Retain this copy for your office files.