

Lee
067
5-67

CODED

MISSISSIPPI BOARD OF WATER COMMISSIONERS

WATER WELL DRILLERS LOG

Date: 5-17, 1967, Driller: Herndon-Homan Well & Supply, Inc.
(When well drilled) P. O. Box 42 County Lee
SHANNON, MISSISSIPPI 38868 (Where well is located)

(1) Owner of Land: Paul G. Rice
(Name)
111 SHANNON, Miss.
(Address)
(2) Location: NW 1/4, SE 1/4, Sec. 30, T11R6E
2 miles SE of Shannon
(distance) (direction) (Nearest Town)
(3) Topography: flat
(Hilly) (Flat) (Level)
(4) Purpose of Well: Home
(Domestic Irrigation
Municipal, Industrial, Other)

Description & Color of Materials Sand, Clay, Red Clay, Shell, etc.	Thick- ness Feet	Depth Feet
<u>surface sand & clay</u>	<u>0</u>	<u>0-20</u>
<u>blue clay</u>	<u>20</u>	<u>20-240</u>
<u>sand</u>	<u>240</u>	<u>240-360</u>
<u>bottom</u>	<u>360</u>	

Information upon completion of well:

(1) Diameter 4 inches.

(2) Total Depth 360 feet.

(3) Water Level 65 feet below top of ground.

(4) Cased to 23', Size 4"

(5) Screen: Size none, Length _____

(6) Were any formations sealed against pollution?
✓ yes, _____ no.

If YES depth of formation 20'

Why surface sand


Drillers Remarks: _____

Yield in gpm: 5

Size pump: 3/4 HP Jet

Type power: electric

CODED

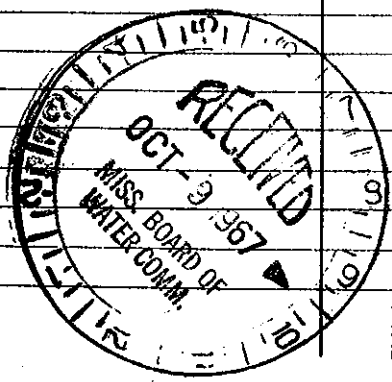

Retain this copy for your office files.