

Lee  
063  
6-67

CODED

MISSISSIPPI BOARD OF WATER COMMISSIONERS

WATER WELL DRILLERS LOG

Herndon-Homan Well & Supply, Inc.

Date: 6-30, 1967, Driller: P. O. Box 42, County Lee  
(When well drilled) SHANNON, MISSISSIPPI 38868 (Where well is located)


1) Owner of Land:	Description & Color of Materials Sand, Clay, Red Clay, Shell, etc.	Thick- ness Feet	Depth Feet
Pines Grove Baptist (Name)	surface sand & clay		0-20
Church (Address)	blue clay		20-220
2) Location: SW 1/4, SW 1/4, Sec. 30, T. 11 S, R. 6 E	mud		220-340
1 1/2 miles S of Shannon (distance) (direction) (Nearest Town)	65 ft		340
3) Topography: flat (Hilly) (Flat) (Level)			
4) Purpose of Well: church (Domestic Irrigation Municipal, Industrial, Other)			

Information upon completion of well:

- 1) Diameter 5 inches.
- 2) Total Depth 340 feet.
- 3) Water Level 60 feet below top of ground.
- 4) Cased to 23', Size 5"
- 5) Screen: Size none, Length \_\_\_\_\_
- 6) Were any formations sealed against pollution?  
 yes,  no.

YES depth of formation 20'  
Why surface + sand  
Drillers Remarks:  
Yield in gpm: 5  
Size pump: 1/2 HP sub  
Type power: electric

CODED

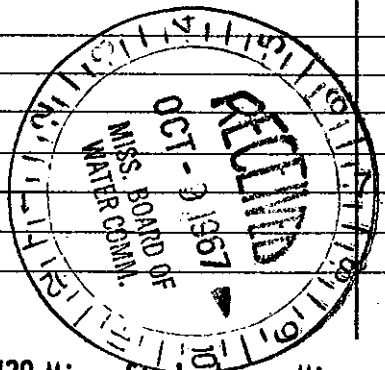

Mail this copy to Board of Water Commissioners 429 Miss. St. Jackson, Miss.