

Lee  
064  
7-67

MISSISSIPPI BOARD OF WATER COMMISSIONERS  
WATER WELL DRILLERS LOG

CODED

Date: 7-5, 1967 (When well drilled)  
Driller: Herndon-Homan Well & Supply, Inc. P. O. Box 42  
SHANNON, MISSISSIPPI 38868 County Lee (Where well is located)


	Description & Color of Materials Sand, Clay, Red Clay, Shell, etc.	Thick- ness Feet	Depth Feet
1) Owner of Land: <u>Tulane Posey</u> (Name)	<u>surface sand &amp; clay</u>	<u>0-18</u>	<u>0-18</u>
At <u>1 Plantersville, Miss</u> (Address)	<u>blue clay</u>	<u>18-150</u>	<u>18-150</u>
2) Location: <u>SE 1/4, NW 1/4, Sec. 2 T. 11 R. 6 E</u> (Distance) (direction) (Nearest Town)	<u>sand</u>	<u>150-300</u>	<u>150-300</u>
4 1/2 miles <u>SE</u> of <u>Plantersville</u> (distance) (direction) (Nearest Town)	<u>Bottom</u>	<u>300</u>	<u>300</u>
3) Topography: <u>Hilly</u> (Hilly) (Flat) (Level)			
4) Purpose of Well: <u>Home</u> (Domestic Irrigation Municipal, Industrial, Other)			

Information upon completion of well:

- 1) Diameter 5 inches.
- 2) Total Depth 300 feet.
- 3) Water Level 60 feet below top of ground.
- 4) Cased to 21 1/8", Size 5"
- 5) Screen: Size none, Length \_\_\_\_\_
- 5) Were any formations sealed against pollution?  
 yes, \_\_\_\_\_ no.

CODED

YES depth of formation 18'  
Why surface & sand  
Drillers Remarks:  
Yield in gpm: 10  
Size pump: 3/4 HP Sub.  
Type power: electric

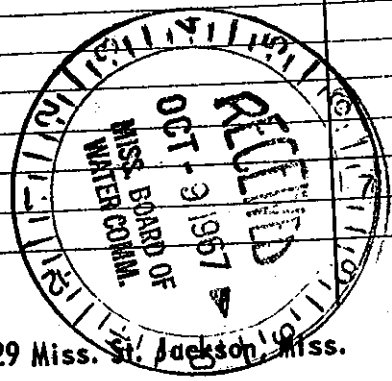

Mail this copy to Board of Water Commissioners 429 Miss. St. Jackson, Miss.