

CODED

Lee
066
12-66



MISSISSIPPI
BOARD OF WATER COMMISSIONERS
416 North State Street
Jackson, Mississippi 39201

WATER WELL DRILLERS LOG

Dec 17 1966 Herndon-Homan Well & Supply, Inc. Lee
date well completed firm Rank Box 42 county well located

SHANNON, MISSISSIPPI 38888

LANDOWNER:	description of formations encountered	from	to
John Morris	surface sand & clay	0	18
Nettleton Miss	Blue clay	18	90
(mailing address)	Sand	90	200
	Bottom	200	
WELL LOCATION:			
sec. 13 T. 11 N. R. 6 E			
2 miles S of Nettleton			
WELL PURPOSE: Home			
(home, irrigation, municipal, industrial)			
WELL COMPLETION DATA:			
(1) diameter (inches)	4"		
(2) total depth (feet)	200'		
(3) static water level (feet)	75' below top of ground		
(4) casing (material)	steel, 21' (depth)		
(5) screen (length)	NO (depth to top)		
(6) pump (HP)	by other (yield gpm)		
(7) electric log	NO (yes or no)		
(8) how well bottom plugged	open		
DRILLERS REMARKS:			
400			

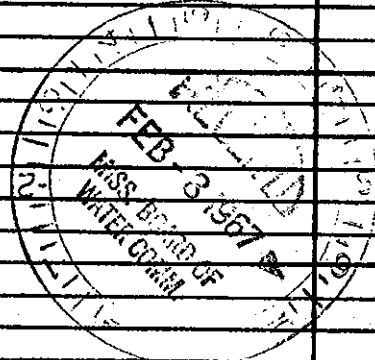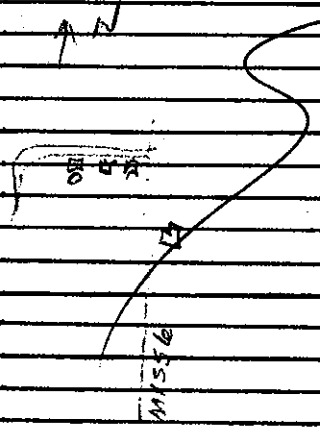

CODED