


**WATER WELL DRILLERS LOG**

LEE  
 069  
 Date: 12-30, 1960, Driller: Ewing Gas Co. County Lee  
 12-30-60

	Description & Color of Materials Sand, Clay, Red Clay, Shell, etc.	Thick- ness Feet	Depth Feet
(1) Owner of Land: <u>Rush Lyons</u> (Name) <u>Nottleton, Miss.</u> (Address)	<u>white sand</u>		
(2) Location: <u>1/4, 1/4, Sec. 18 T1 R7</u>  miles _____, of _____ (distance) (direction) (Nearest Town)	<u>well on S. side</u>		
(3) Topography: _____ (Hilly) (Flat) (Level)			
(4) Purpose of Well: <u>Household</u> (Domestic Irrigation Municipal, Industrial, Other)			
Information upon completion of well:			
(1) Diameter <u>4</u> inches.			
(2) Total Depth <u>206</u> feet.			
(3) Water Level <u>70'</u> feet below top of ground.			
(4) Cased to <u>27'</u> , Size _____			
(5) Screen: Size _____, Length _____			
(6) Were any formations sealed against pollution? <input checked="" type="checkbox"/> yes, _____ no.			
If YES depth of formation <u>27'</u>			
Why _____			
Drillers Remarks: _____			
_____			
<u>267</u>			

**INDEXED**

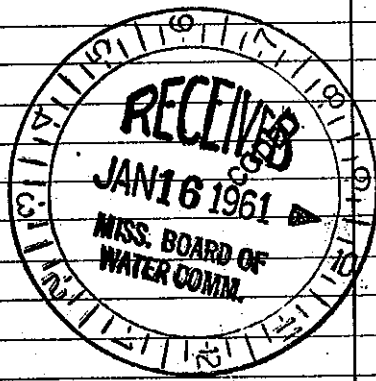

Well No.

(Use Back Side)

Mail this copy to Board of Water Commissioners 429 Miss. St. Jackson, Miss