

LEE
071
11-2-60

0 301

WATER WELL DRILLERS LOG

Herndon Well & Supply Co.

Date: Nov 2, 1960, Driller: SHANNON, MISS. County Lee
(Name)


	Description & Color of Materials Sand, Clay, Red Clay, Shell, etc.	Thick- ness Feet	Depth Feet
(1) Owner of Land: <u>Charles Collins</u> (Name) <u>PO Box Shannon, Miss</u> (Address)	<u>Sand & clay</u>		15
(2) Location: <u>1/4</u> , <u>1/4</u> , Sec. <u>5 T11R4</u> <u>2</u> miles <u>NE</u> , of <u>Shannon</u> (distance) (direction) (Nearest Town)	<u>Blue Shale</u> <u>Sand</u>		240
(3) Topography: <u>Flat</u> (Hilly) (Flat) (Level)	<u>Bottom</u>		350
(4) Purpose of Well: <u>Home use</u> (Domestic Irrigation Municipal, Industrial, Other)			

Information upon completion of well:


- (1) Diameter 4 inches.
- (2) Total Depth 350 feet.
- (3) Water Level 70 feet below top of ground.
- (4) Cased to 20' 2", Size 4"
- (5) Screen: Size —, Length —
- (6) Were any formations sealed against pollution?
X yes, — no.

If YES depth of formation 15 ft
Why Subsided Sand

Drillers Remarks:
265

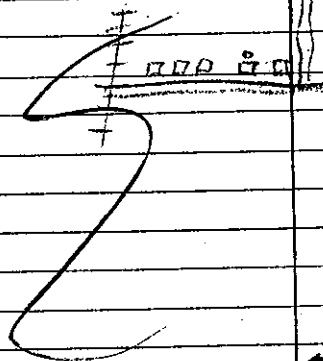

CODED

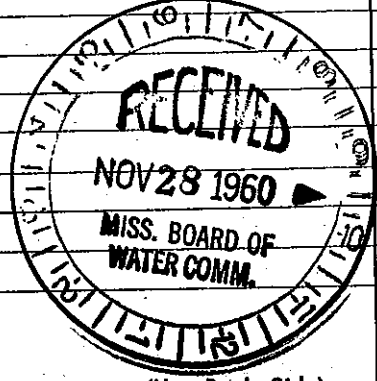

(Use Back Side)

Well No.

Retain this copy for your office files.