

LEE
 072
 6-17-61

MISSISSIPPI BOARD OF WATER COMMISSIONERS

WATER WELL DRILLERS LOG

HERNDON WELL & SUPPLY CO.

Date: June 17, 1961, Driller: P. O. BOX 42 County Lee
 SHANNON, MISSISSIPPI

	Description & Color of Materials Sand, Clay, Red Clay, Shell, etc.	Thick- ness Feet	Depth Feet
(1) Owner of Land: <u>Bill Burk</u> (Name) <u>Wetter, Miss</u> (Contractor) (Address)	<u>Surface sand</u> <u>& clay</u>		0
(2) Location: $\frac{1}{4}$, $\frac{1}{4}$, Sec <u>24</u> T <u>11S</u> R <u>6E</u> <u>1 1/2</u> miles <u>West</u> of <u>Wetter</u> (distance) (direction) (Nearest Town)	<u>Blue rock</u> <u>& sand</u>		35 80
(3) Topography: <u>Flat</u> (Hilly) (Flat) (Level)	<u>Bottom</u>		200
(4) Purpose of Well: <u>Domestic</u> (Domestic Irrigation Municipal, Industrial, Other)			


Information upon completion of well:

- (1) Diameter 4 inches.
- (2) Total Depth 200 feet.
- (3) Water Level 75 feet below top of ground.
- (4) Cased to 39', Size 4"
- (5) Screen: Size _____, Length _____
- (6) Were any formations sealed against pollution?
 yes, no.

If YES depth of formation _____

Why Surface & Sand

Drillers Remarks: _____

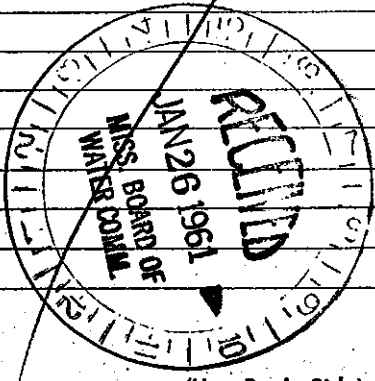

(Use Back Side)

Well No.

276