

LEE

MISSISSIPPI BOARD OF WATER COMMISSIONERS

075

3-20-68

WATER WELL DRILLERS LOG

SHANNON WELL & SUPPLY CO.

Date: 5/28/68, 1968, Driller: SHANNON, MISSISSIPPI County: Lee

(1) Owner of Land	Description & Color of Materials Sand, Clay, Red Clay, Shell, etc.	Thick- ness Feet	Depth Feet
Mr. Willeg Shroyer (Name) Rt Nettleton, Miss (Address)	surface sand & clay		0
(2) Location: 1/4, 1/4, Sec. 23, R. 6E 2 miles N of Nettleton (distance) (direction) (Nearest Town)	Blue rock	8	26
(3) Topography: flat (Hilly) (Flat) (Level)	Sand	8	100
(4) Purpose of Well: Domestic (Domestic Irrigation Municipal, Industrial, Other)	Bottom		220

Information upon completion of well:


- (1) Diameter 4 inches.
- (2) Total Depth 220 feet.
- (3) Water Level 70 feet below top of ground.
- (4) Cased to 25', Size 4"
- (5) Screen: Size —, Length —
- (6) Were any formations sealed against pollution?
yes, no.

If YES depth of formation 26'

Why surface & sand

Drillers Remarks:

296

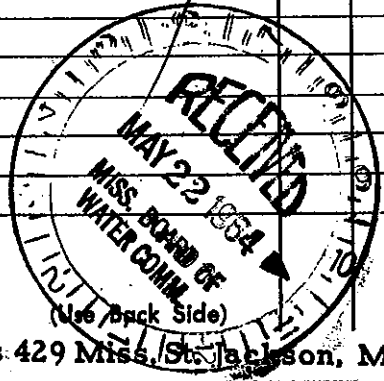

Well No.

Mail this copy to Board of Water Commissioners 429 Miss. St. Jackson, Miss