

MISSISSIPPI BOARD OF WATER COMMISSIONERS

WATER WELL DRILLERS LOG
NERNDON WELL & SUPPLY CO.

LEE
 076
 11-14-62
 CODED

Date: Nov 14, 1962, Driller: SWANNON, MISSISSIPPI County Lee
P. O. BOX 42
(Name)

(1) Owner of Land: Tom Hubbard
(Name)
Shannon, Miss.
(Address)

(2) Location: 1/4, 1/4, Sec 14 T 11S R 6E
1 miles — of Shannon
(distance) (direction) (Nearest Town)

(3) Topography: Flat
(Hilly) (Flat) (Level)

(4) Purpose of Well: Domestic
(Domestic Irrigation Municipal, Industrial, Other)

Description & Color of Materials Sand, Clay, Red Clay, Shell, etc.	Thick- ness Feet	Depth Feet
<u>surface sand</u>		0
<u>& clay</u>		
<u>Blue sand</u>		20
<u>sand</u>		280
<u>Bottom</u>		400

Information upon completion of well:

(1) Diameter 5 inches.

(2) Total Depth 400 feet.

(3) Water Level 90 feet below top of ground.

(4) Cased to 23' 5", Size 5"


(5) Screen: Size —, Length —

(6) Were any formations sealed against pollution?
 yes, no.

If YES depth of formation 20 ft.

Why surface & sand

Drillers Remarks:

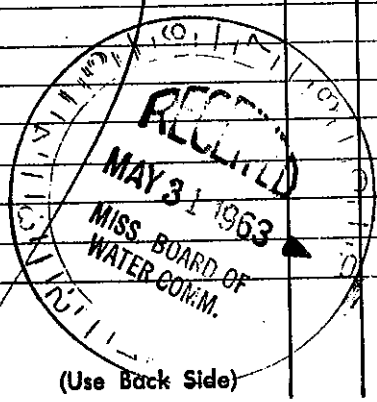

293

Well No.

Mail this copy to Board of Water Commissioners 429 Miss. St. Jackson, Miss.