

LEE

MISSISSIPPI BOARD OF WATER COMMISSIONERS

077

5-14-63

WATER WELL DRILLERS LOG

Date: 5/14/63, Driller: HENDON WELL & SUPPLY CO. County: Lee

Phone BOX 42 SHANNON, MISSISSIPPI

(1) Owner of Land:	Description & Color of Materials Sand, Clay, Red Clay, Shell, etc.	Thick- ness Feet	Depth Feet
(Name) <u>Donald Johnson</u> (Address) <u>Rt 2 Shannon, Miss</u>	<u>surface sand & clay</u>		<u>0</u>
(2) Location: <u>1/4</u> , <u>1/4</u> , Sec. <u>4</u> T <u>11</u> R <u>6E</u> <u>3</u> miles <u>NE</u> , of <u>Shannon</u> (distance) (direction) (Nearest Town)	<u>Blue-gray sand</u>		<u>20</u>
(3) Topography: <u>flat</u> (Hilly) (Flat) (Level)	<u>to</u>		<u>140</u>
(4) Purpose of Well: <u>domestic</u> (Domestic Irrigation Municipal, Industrial, Other)	<u>Bottom</u>		<u>300</u>

Information upon completion of well:


- (1) Diameter 4 inches.
- (2) Total Depth 300 feet.
- (3) Water Level _____ feet below top of ground.
- (4) Cased to 23' 2", Size 4"
- (5) Screen: Size _____, Length _____.
- (6) Were any formations sealed against pollution?
 yes, _____ no.

If YES depth of formation 20'

Why surface & sand

Drillers Remarks: Hard to maintain well

300 FLED 272

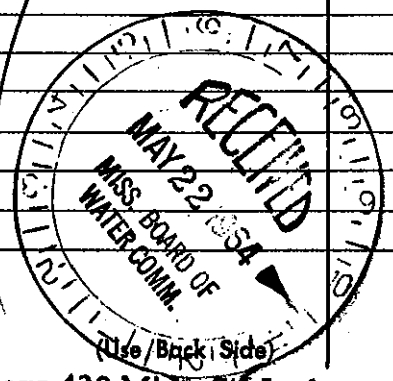

Well No.

Mail this copy to Board of Water Commissioners 429 Miss. St. Jackson, Miss