

MISSISSIPPI BOARD OF WATER COMMISSIONERS

LEE  
0-80  
9-6-60

WATER WELL DRILLERS LOG  
Herndon Well & Supply Co.  
SHANNON, MISS.

Date: Sept 6, 19 60 Driller: \_\_\_\_\_ County Lee

(Name)

(1) Owner of Land: Contractors  
(Name)  
Black Building Supply  
(Address) Natchez

(2) Location: 1/4, 1/4, Sec. T R. R,  
4 miles North, of Natchez  
(distance) (direction) (Nearest Town)

(3) Topography: Flat  
(Hilly) (Flat) (Level)

(4) Purpose of Well: House water  
(Domestic Irrigation  
Municipal, Industrial, Other)

Description & Color of Materials Sand, Clay, Red Clay, Shell, etc.	Thick- ness Feet	Depth Feet
<u>Clay &amp; Sand</u>		<u>36</u>
<u>Blue Rock</u>		<u>120</u>
<u>Sand</u>		
<u>Bottom</u>		<u>240</u>

Information upon completion of well:

(1) Diameter 4" inches.

(2) Total Depth 240 feet.

(3) Water Level \_\_\_\_\_ feet below top of ground.

(4) Cased to 42 ft Size 4"


(5) Screen: Size \_\_\_\_\_, Length \_\_\_\_\_

(6) Were any formations sealed against pollution?  
X yes, \_\_\_\_\_ no.

If YES depth of formation 42 ft  
Why Surface & Sand

Drillers Remarks: \_\_\_\_\_

263 ?

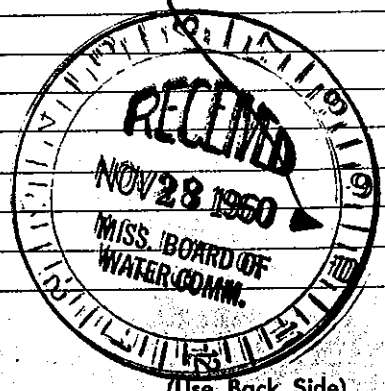

Well No. \_\_\_\_\_

Mail this copy to Board of Water Commissioners 429 Miss. St. Jackson, Miss.