

LEE
 O III
 2-15-74

MISSISSIPPI
 BOARD OF WATER COMMISSIONERS
 416 North State Street
 Jackson, Mississippi 39201

CODED

WATER WELL DRILLERS LOG

Herman Homan Well & Supply, Inc.

P. O. Box 12

Lee


2-15-1974
 date well completed

SHANNON, MISSISSIPPI 38868

county well located

LANDOWNER:	description of formations encountered	from	to
To Ann Cavathes Rt 2, Shannon Miss. (mailing address)			
WELL LOCATION:			
sec. 21 T. 11 N. R. 6 E. 1 3/4 miles E of SHANNON (distance) (direction) (nearest town)			
WELL PURPOSE: Home (home, irrigation, municipal, industrial)			
WELL COMPLETION DATA:			
(1) diameter (inches) 5"			
(2) total depth (feet) 340'			
(3) static water level (feet) 83' below above top of ground.			
(4) casing steel, 20' 8" (material) (depth) 5" (size) if telescope see back.			
(5) screen NO (length) (depth to top) (size) (material)			
(6) pump 1 (HP) 5 (yield gpm) electric (type power)			
(7) electric log NO (yes or no) (organization running log)			
(8) how well bottom plugged open			

CODED

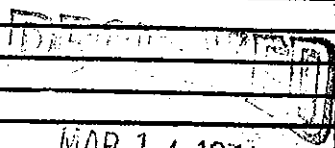

MAR 14 1974

OF WATER COMM

DRILLERS REMARKS: