

Lee
 O 2000
 7-68

MISSISSIPPI
 BOARD OF WATER COMMISSIONERS
 416 North State Street
 Jackson, Mississippi 39201
 WATER WELL DRILLERS LOG

7-18 1968 Herron-Homan Well & Supply, Inc. Lee
 date well completed firm name, address, city, state, zip
 Box 42


LANDOWNER:
Joe Dye
Rt 2 Sharrou, Miss.
 (mailing address)

description of formations encountered	from	to
<u>Super sand</u>	<u>0</u>	<u>18</u>
<u>Clay</u>	<u>18</u>	<u>180</u>
<u>Sand</u>	<u>180</u>	<u>300</u>
<u>Bit</u>	<u>300</u>	

WELL LOCATION:
 sec. 9 T 11 N R 6 E
2 miles NE of Sharrou
 (distance) (direction) (nearest town)

WELL PURPOSE: Home
 (home, irrigation, municipal, industrial)

- WELL COMPLETION DATA:
- (1) diameter (inches) 5"
 - (2) total depth (feet) 300'
 - (3) static water level (feet) 9' below top of ground.
 - (4) casing Steel, 21'6" (material) (depth)
5" if telescope see back. (size)
 - (5) screen NO (length) (depth to top)
 (size) (material)
 - (6) pump 3/4 HP 500 (HP) (yield gpm)
 (type power)
 - (7) electric log NO (yes or no)
 (organization running log)
 - (8) how well bottom plugged open

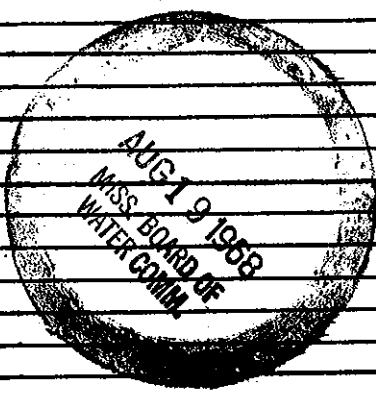

DRILLERS REMARKS: