

Lee  
 O 2001  
 8-68

MISSISSIPPI  
 BOARD OF WATER COMMISSIONERS  
 416 North State Street  
 Jackson, Mississippi 39201

WATER WELL DRILLERS LOG

Herndon-Homan Well & Supply, Inc. Lee  
 P.O. Box 42  
 SHANNON, MISSISSIPPI 38851  
 county well located

8-5 1968  
 date well completed

LANDOWNER:

Melvin Coker  
 Rt 2 Shannon, Miss  
 (mailing address)

description of formations encountered

description of formations encountered	from	to
Surface sand	0	18
& clay		
Blue clay	18	200
Sand	200	340
Bottom	340	

WELL LOCATION:


sec. 20 T. 11 N. R. 6 E  
 1/2 miles E of Shannon  
 (distance) (direction) (nearest town)

WELL PURPOSE:

(home, irrigation, municipal, industrial)

WELL COMPLETION DATA:

- (1) diameter (inches) 5"
- (2) total depth (feet) 340'
- (3) static water level (feet) 60' below top of ground.
- (4) casing (material), (depth) 21' 4"
- (5) screen (size) 5" If telescope see back.
- (6) pump (HP) 3/4 (material) 5 (yield gpm) electric (type power)
- (7) electric log (yes or no) NO
- (8) how well bottom plugged open

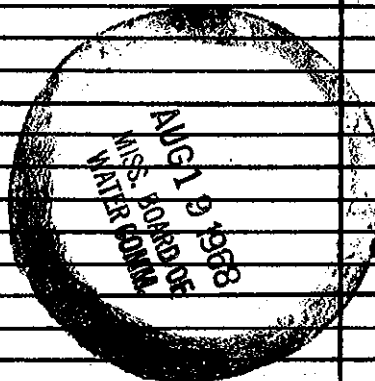

DRILLERS REMARKS: