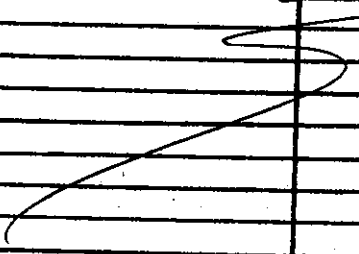


Lee  
 0 2011  
 15-26-77

MISSISSIPPI  
 BOARD OF WATER COMMISSIONERS  
 416 North State Street  
 Jackson, Mississippi 39201

WATER WELL DRILLERS LOG

5-26-77 date well completed  
 130 77 Herman Homan Well & Supply, Inc.  
 P. O. Box 42  
 SHANNON, MISSISSIPPI 38868  
 Lee county well located

LANDOWNER:	description of formations encountered	from	to
Raymond Hampton Rt 2 SHANNON, MS. (mailing address)	Surface sand Blue Clay Sand Gravel	0	160 180 320
WELL LOCATION: sec. 21 T. 11 N. R. 6 E. S. 5 W. 1 miles E of SHANNON (distance) (direction) (nearest town)			
WELL PURPOSE: Home (home, irrigation, municipal, industrial)			
WELL COMPLETION DATA:			
(1) diameter (inches) 4"			
(2) total depth (feet) 320'			
(3) static water level (feet) 87' below top of ground.			
(4) casing (material) steel, (depth) 212'			
4" (size) If telescope see back.			
(5) screen (length) (depth to top)			
(size) (material)			
(6) pump (HP) (yield gpm) electric (type power)			
(7) electric log (yes or no)			
(organization running log)			
(8) how well bottom plugged open			
DRILLERS REMARKS:			

**RECEIVED**

JUN 1 1977

MISS. BD. OF WATER COMM.