

DRILLERS LOG

LEE

Date: May 16, 1961, Driller: Ewing Gas Co. County Lee
(Name)

5-16-61
(1) Owner of Land: A. L. Inammel
(Name)

Nettleton Miss.
(Address)

(2) Location: $\frac{1}{4}$, $\frac{1}{4}$, Sec: 21 T. 7E R.
4 miles E of Nettleton
(distance) (direction) (Nearest Town)


(3) Topography: (Hilly) (Flat) (Level)

(4) Purpose of Well: household
(Domestic Irrigation, Municipal, Industrial, Other)

Description & Color of Materials Sand, Clay, Red Clay, Shell, etc.	Thick- ness Feet	Depth Feet
Clay	0	20
Blue clay	20	80
Sand	80	165

Information upon completion of well:

- (1) Diameter 4 inches.
- (2) Total Depth 165 feet.
- (3) Water Level 50 feet below top of ground.
- (4) Cased to 23' 4", Size _____
- (5) Screen: Size _____, Length _____
- (6) Were any formations sealed against pollution?
yes, _____ no.
- If YES depth of formation 23' 4"
- Why _____
- Drillers Remarks: _____

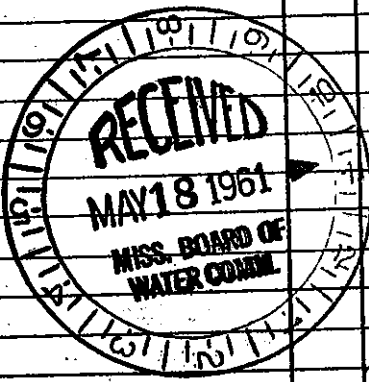

272

Well No.

(Use Back Side)

Mail this copy to Board of Water Commissioners 429 Miss. St. Jackson, Miss.