

LEE MISSISSIPPI BOARD OF WATER COMMISSIONERS

P 13
10-10-65

WATER WELL DRILLERS LOG

Date: Oct. 10, 1965, Driller: Herndon-Homan Well & Supply, Inc.
P. O. Box 42 County Lee
SHANNON, MISSISSIPPI 38668

(1) Owner of Land: <u>A. L. Temple</u> <small>(Name)</small>	Description & Color of Materials Sand, Clay, Red Clay, Shell, etc.	Thick- ness Feet	Depth Feet
<u>Nettleton, Miss</u> <small>(Address)</small>	<u>hardpan sand & clay</u>	<u>0-8</u>	<u>0-8</u>
(2) Location: <u>7 1/2</u> Sec. <u>157</u> T. <u>7</u> R. <u>7</u>	<u>blue clay</u>	<u>8-36</u>	<u>8-36</u>
<u>2</u> miles <u>N.</u> of <u>Nettleton</u> <small>(distance) (direction) (Nearest Town)</small>	<u>blue clay</u>	<u>36-90</u>	<u>36-90</u>
(3) Topography: <u>flat</u> <small>(Hilly) (Flat) (Level)</small>	<u>sand</u>	<u>90-200</u>	<u>90-200</u>
(4) Purpose of Well: <u>Domestic</u> <small>(Domestic Irrigation Municipal, Industrial, Other)</small>	<u>bottom</u>	<u>200</u>	<u>200</u>

Information upon completion of well:

(1) Diameter 4 inches.

(2) Total Depth 200 feet.

(3) Water Level 60 feet below top of ground.

(4) Cased to 40' 6", Size 4"

(5) Screen: Size -, Length -


(6) Were any formations sealed against pollution?
- yes, - no.

If YES depth of formation _____

Why _____

Drillers Remarks: _____

304 (L.O.) 332

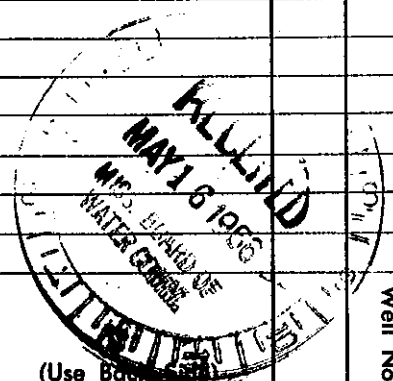

Well No. _____

Mail this copy to Board of Water Commissioners 429 Miss. St. Jackson, Miss.