

WATER WELL DRILLER

LEE
 PLS
 2-14-62-14
 Date: 2-14-62 Driller: JAMES FOWLER County LEE
 (Name)

(1) Owner of Land: Billy Coops
 (Name)
Netherton, Miss.
 (Address)

Description & Color of Materials
 Sand, Clay, Red Clay, Shell, etc.

Thick-
ness
Feet

Depth
Feet

Gravel 60
Blue Clay 40
Sand 100

(2) Location: 1/4, 1/4, Sec 22 T5 R7
4 miles NE of Netherton
 (distance) (direction) (Nearest Town)

(3) Topography: Hilly
 (Hilly) (Flat) (Level)

(4) Purpose of Well: Domestic
 (Domestic Irrigation
 Municipal, Industrial, Other)

Information upon completion of well:

(1) Diameter 4 inches.

(2) Total Depth 206 feet.

(3) Water Level 45 feet below top of ground.

(4) Cased to 65', Size 4"

(5) Screen: Size _____, Length _____


(6) Were any formations sealed against pollution?

yes, _____ no.

If YES depth of formation 65'

Why to cut off seepage

Drillers Remarks: Good water

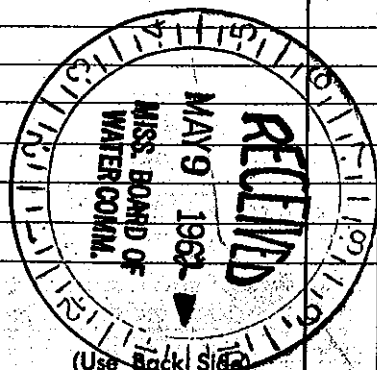

Well No.

314 ELEV 300

Mail this copy to Board of Water Commissioners 429 Miss. St. Jackson, Miss.