

LEE
P 16
4-20-62

MISSISSIPPI BOARD OF WATER COMMISSIONERS

WATER WELL DRILLERS LOG

HERNDON WELL & SUPPLY CO.

Date: April 20, 1962, Driller: HERNDON P. O. BOX 42
SHANNON, MISSISSIPPI County Lee

	Description & Color of Materials Sand, Clay, Red Clay, Shell, etc.	Thick- ness Feet	Depth Feet
(1) Owner of Land: <u>Doyle Young</u> (Name) <u>Nettleton, Miss</u> (Address)	<u>gravel and clay</u>		<u>0</u>
(2) Location: <u>1/4</u> , <u>1/4</u> , Sec <u>22 115</u> T <u>R 7E</u> <u>5</u> miles <u>NE</u> of <u>Nettleton</u> (distance) (direction) (Nearest Town)	<u>Blue sand</u> <u>sand</u>	<u>35</u> <u>40</u>	
(3) Topography: <u>Hilly</u> (Hilly) (Flat) (Level)	<u>8</u>		
(4) Purpose of Well: <u>Domestic</u> (Domestic Irrigation Municipal, Industrial, Other)	<u>Bottom</u>		<u>140</u>

Information upon completion of well:


- (1) Diameter 4 inches.
- (2) Total Depth 140 feet.
- (3) Water Level 50 feet below top of ground. 6/16 2/28/67
- (4) Cased to 37'8", Size 4"
- (5) Screen: Size —, Length —
- (6) Were any formations sealed against pollution?
 yes, no.

If YES depth of formation 35

Why gravel & sand

Drillers Remarks: _____

316 ELAN 318

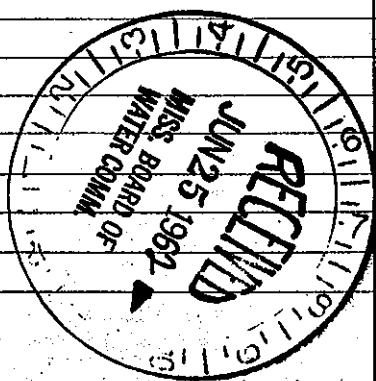

Well No. _____