

LEE

MISSISSIPPI BOARD OF WATER COMMISSIONERS

P 17

8-24-62

WATER WELL DRILLERS LOG

HERNDON WELL & SUPPLY CO.

Date: Aug 24, 1962, Driller: P. O. BOX 42, County Lee

WALTON, MISSISSIPPI (Name)

(1) Owner of Land:	Description & Color of Materials Sand, Clay, Red Clay, Shell, etc.	Thick- ness Feet	Depth Feet
D. B. Coggins (Name)	surface sand		0
Natchez, Miss (Address)	red clay		
(2) Location: 1/4, 1/4, Sec 9, T 15, R 7E	Blue sand		18
miles NE, of Natchez (distance) (direction) (Nearest Town)	sand		70
(3) Topography: Flat (Hilly) (Flat) (Level)	to		
(4) Purpose of Well: Domestic (Domestic Irrigation Municipal, Industrial, Other)	Bottom		200

Information upon completion of well:


- (1) Diameter 4 inches.
- (2) Total Depth 200 feet.
- (3) Water Level 70 feet below top of ground.
- (4) Cased to 20' 6", Size 4 1/2
- (5) Screen: Size \_\_\_\_\_, Length \_\_\_\_\_
- (6) Were any formations sealed against pollution?  
yes, no.

If YES depth of formation 18'

Why surface & sand

Drillers Remarks:

319 ELEV 302

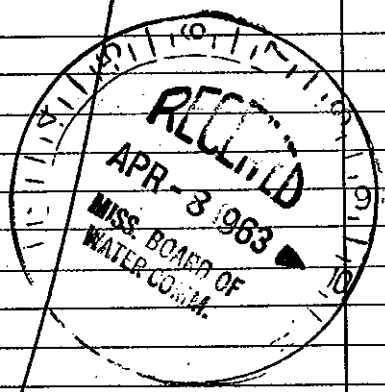

(Use Back Side)

Well No.

Mail this copy to Board of Water Commissioners 429 Miss. St. Jackson, Miss