

LEE
P18
10-6-62

MISSISSIPPI BOARD OF WATER COMMISSIONERS

WATER WELL DRILLERS LOG
HERNDON WELL & SUPPLY CO.

P. O. BOX 42


Date: Feb 6, 1962, Driller: STANNON, MISSISSIPPI County Lee
(Name)

	Description & Color of Materials Sand, Clay, Red Clay, Shell, etc.	Thick- ness Feet	Depth Feet
(1) Owner of Land: <u>Robert G. Estes</u> (Name) <u>Nettleton, Miss.</u> (Address)	<u>sand & clay</u>		<u>0</u>
(2) Location: $\frac{1}{4}$, $\frac{1}{4}$, Sec. <u>30</u> T. <u>115</u> R. <u>7E</u> <u>1/2</u> miles <u>E</u> , of <u>Nettleton</u> (distance) (direction) (Nearest Town)	<u>Blue water</u>		<u>38</u>
(3) Topography: <u>Flat</u> (Hilly) (Flat) (Level)	<u>Sand</u>		<u>100</u>
(4) Purpose of Well: <u>Domestic</u> (Domestic Irrigation Municipal, Industrial, Other)	<u>Bottom</u>		<u>180</u>

Information upon completion of well:

- (1) Diameter 4 inches.
 (2) Total Depth 180 feet.
 (3) Water Level 70 feet below top of ground.
 (4) Cased to 42' 6", Size 4"
 (5) Screen: Size , Length .
 (6) Were any formations sealed against pollution?
 yes, no.

If YES depth of formation 38'
 Why surface & sand
 Drillers Remarks: old brick

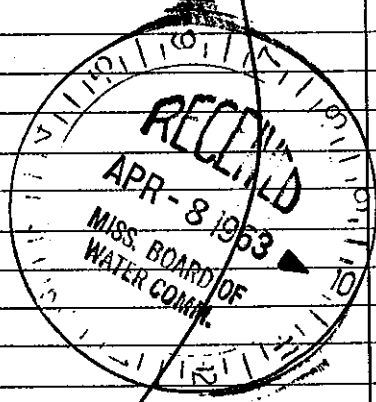

321 ELEV 275

(Use Back Side)

Well No.