

LEE

MISSISSIPPI BOARD OF WATER COMMISSIONERS

P 19

WATER WELL DRILLERS LOG

9-3-63

HERNDON WELL & SUPPLY CO.

Date: 9/3, 1963, Driller: P. O. BOX 42 County Lee SHANNON, MISSISSIPPI

(1) Owner of Land: <u>G. H. Waycaster</u> (Name)	Description & Color of Materials Sand, Clay, Red Clay, Shell, etc.	Thick- ness Feet	Depth Feet
<u>Nettleton, Miss.</u> (Address)	<u>surface sand &amp; clay</u>		<u>0</u>
(2) Location: <u>NW 1/4, NW 1/4, Sec 30 T 11 S R 7 E</u> <u>1/2</u> miles <u>N</u> of <u>Nettleton</u> (distance) (direction) (Nearest Town)	<u>blue rock</u>		<u>22</u>
(3) Topography: <u>flat</u> (Hilly) (Flat) (Level)	<u>bond</u>		<u>80</u>
(4) Purpose of Well: <u>Domestic</u> (Domestic Irrigation Municipal, Industrial, Other)	<u>bottom</u>		<u>180</u>

Information upon completion of well:


- (1) Diameter 4 inches.
- (2) Total Depth 180 feet.
- (3) Water Level 40 <sup>47.2 2/28/67</sup> feet below top of ground.
- (4) Cased to 26' 2", Size 44
- (5) Screen: Size —, Length —
- (6) Were any formations sealed against pollution?  
— yes, — no.

If YES depth of formation 22'

Why surface sand

Drillers Remarks:

328 ELEV 270

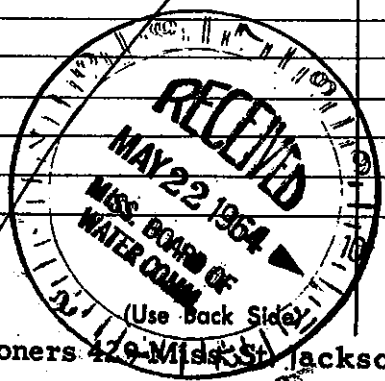

Well No.

Mail this copy to Board of Water Commissioners 429 Miss. St. Jackson, Miss