

LEE MISSISSIPPI BOARD OF WATER COMMISSIONERS

P20

12-4-65

WATER WELL DRILLERS LOG

Herndon-Homan Well & Supply, Inc.

P. O. Box 42

Date: Dec 4, 1963, Driller: SHANNON, MISSISSIPPI County Lee

(Name)

(1) Owner of Land:	Description & Color of Materials Sand, Clay, Red Clay, Shell, etc.	Thick- ness Feet	Depth Feet
Name: <u>EDD BURGESS</u>			
Address: <u>Nettleton, Miss.</u>	<u>sand + clay</u>		<u>0-20</u>
Location: $\frac{1}{4}$, $\frac{1}{4}$, Sec. <u>19 T¹³ R^{7E}</u>	<u>blue clay</u>		<u>20-90</u>
Distance: <u>1/2</u> miles <u>NE</u> , of <u>Nettleton</u>	<u>sand</u>		<u>90-200</u>
Topography: <u>FLAT</u>	<u>Bottom</u>		<u>200</u>
Purpose of Well: <u>Domestic</u>			

Information upon completion of well:

(1) Diameter 4 inches.

(2) Total Depth 200 feet.

(3) Water Level 70 feet below top of ground.

(4) Cased to 24', Size 4"


(5) Screen: Size , Length

(6) Were any formations sealed against pollution?
 yes, no.

If YES depth of formation 20'

Why surface & sand

Drillers Remarks:

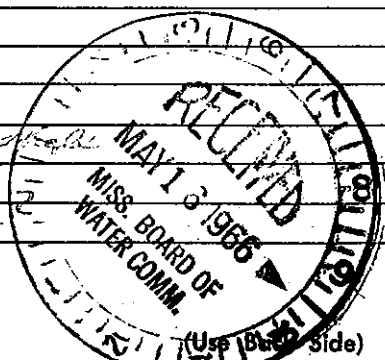

Well No.

336 5681 300

Mail this copy to Board of Water Commissioners 429 Miss. St. Jackson, Miss.