

CODED

LEE
P25
368

MISSISSIPPI
BOARD OF WATER COMMISSIONERS
416 North State Street
Jackson, Mississippi 39201

WATER WELL DRILLERS LOG

3-15-68 date well completed
Morndon-Roman Well & Supply, Inc. Lee
P.O. Box 48 county well located
MEMPHIS, MISSISSIPPI 38008

LANDOWNER:

John Fowler
Nettleton, Miss
(mailing address)

description of formations encountered

Surface sand & clay
Blue clay
SAND
Bottom
from 0 to 30
30 to 80
80 to 240
240

WELL LOCATION:


sec. 30 T. 11 N. R. 7 E.
1 miles NE of Nettleton
(distance) (direction) (nearest town)

WELL PURPOSE:

Home
(home, irrigation, municipal, industrial)

WELL COMPLETION DATA:

- (1) diameter (inches) 5
- (2) total depth (feet) 240
- (3) static water level (feet) 84 below top of ground.
- (4) casing Steel, 33' 5" (material) (depth)
if telescope see back.
- (5) screen NONE (length) (depth to top)
(size) (material)
- (6) pump 3/4 (HP) 3 (yield gpm)
electric (type power)
- (7) electric log No (yes or no)
(organization running log)
- (8) how well bottom plugged open

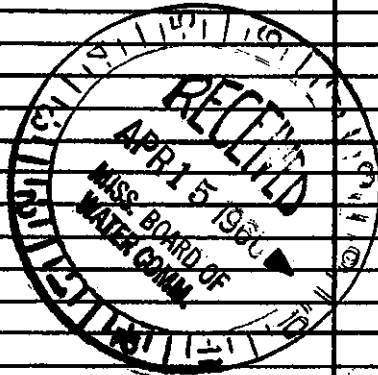

DRILLERS REMARKS: