

LEE  
F28  
9-67

MISSISSIPPI BOARD OF WATER COMMISSIONERS

### WATER WELL DRILLERS LOG

Date: 9/31, 1967, Driller: Herndon-Homan Well & Supply, Inc. County: Lee  
(When well drilled) SHANNON, MISSISSIPPI 38400 (Where well is located)

		Description & Color of Materials Sand, Clay, Red Clay, Shell, etc.	Thick- ness Feet	Depth Feet
(1) Owner of Land:	<u>Eugene Baskin</u> (Name)			
(Contractor)	<u>Tupelo, Miss</u> (Address)	<u>surface sand</u>	<u>0</u>	<u>38</u>
(2) Location:	<u>NE 1/4, NE 1/4, Sec. 7 T.11R.7E</u>	<u>Blue clay</u>	<u>38-120</u>	
	<u>3 miles NE</u> of <u>Waltham</u> (distance) (direction) (Nearest Town)	<u>Sand</u>	<u>120-240</u>	
		<u>Both</u>	<u>240</u>	
(3) Topography:	<u>flat</u> (Hilly) (Flat) (Level)			
(4) Purpose of Well:	<u>Home</u> (Domestic Irrigation Municipal, Industrial, Other)			

#### Information upon completion of well:

- (1) Diameter 5 inches.
- (2) Total Depth 240 feet.
- (3) Water Level 95' feet below top of ground.
- (4) Cased to 42' 4", Size 5"
- (5) Screen: Size 40/40, Length \_\_\_\_\_
- (6) Were any formations sealed against pollution?  
 yes,  no.

If YES depth of formation 38'


Why surface sand

Drillers Remarks: \_\_\_\_\_

Yield in gpm: 5

Size pump: 1/2 HP sub.

Type power: electric

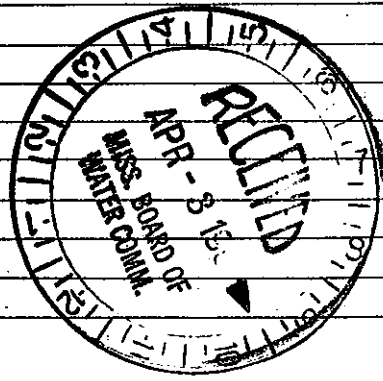

Mail this copy to Board of Water Commissioners 429 Miss. St. Jackson, Miss.