

Lee
P30
7-66

CODED

MISSISSIPPI BOARD OF WATER COMMISSIONERS

WATER WELL DRILLERS LOG

Herndon-Homan Well & Supply, Inc.

Date: July 18, 1966, Driller: P. O. Box 42
SHANNON, MISSISSIPPI 38600 Lee
(When well drilled) (Name) (Where well is located)

(1) Owner of Land	Description & Color of Materials Sand, Clay, Red Clay, Shell, etc.	Thick- ness Feet	Depth Feet
<u>Mr. B. B. Loggins</u> (Name) <u>Nettleton, Miss.</u> (Address)	<u>surface sand</u>		
(2) Location: <u>SW 1/4, NE 1/4, Sec. 16 T11S R7E</u> <u>3 miles NE</u> of <u>Nettleton</u> (distance) (direction) (Nearest Town)	<u>Blue clay</u> <u>sand</u> <u>Bottom</u>	<u>0-20</u> <u>20-115</u> <u>115-240</u> <u>240</u>	
(3) Topography: <u>Flat</u> (Hilly) (Flat) (Level)			
(4) Purpose of Well: <u>Domestic</u> (Domestic Irrigation Municipal, Industrial, Other)			

Information upon completion of well:

(1) Diameter 4 inches.

(2) Total Depth 240 feet.

(3) Water Level 55' feet below top of ground.

(4) Cased to 23', Size 4".

(5) Screen: Size none, Length —.

(6) Were any formations sealed against pollution?
 yes, no.

If YES depth of formation 20'


Why surface & sand

Drillers Remarks: _____

Yield in gpm: 3 gpm

Size pump: 3/4 HP 3/4"

Type power: Electric

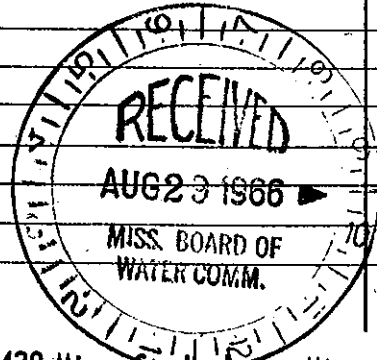

Mail this copy to Board of Water Commissioners 429 Miss. St. Jackson, Miss.