

Lee
P31
9-66

CODED

MISSISSIPPI BOARD OF WATER COMMISSIONERS

WATER WELL DRILLERS LOG

Herndon-Homan Well & Supply, Inc.

Date: Sept 20, 1966, Driller: P. O. Box 42 County Lee
(When well drilled) SHANNON, MISSISSIPPI 38868 (Where well is located)


(1) Owner of Land:	Description & Color of Materials Sand, Clay, Red Clay, Shell, etc.	Thick- ness Feet	Depth Feet
<u>Robert Holcomb</u> (Name)	<u>surface sand & clay</u>		
<u>At Nettleton, Miss</u> (Address)	<u>blue clay</u>		<u>0-18</u>
(2) Location: <u>SW 1/4, NW 1/4, Sec. 7 T11R1E</u>	<u>sand</u>		<u>18-140</u>
<u>3</u> miles <u>NE</u> of <u>Nettleton</u> (distance) (direction) (Nearest Town)	<u>bottom</u>		<u>140-260</u>
(3) Topography: <u>rolling</u> (Hilly) (Flat) (Level)			
(4) Purpose of Well: <u>Home</u> (Domestic Irrigation Municipal, Industrial, Other)			

Information upon completion of well:

- (1) Diameter 4 inches.
- (2) Total Depth 260 feet.
- (3) Water Level 90 feet below top of ground.
- (4) Cased to 21' 4", Size 4"
- (5) Screen: Size NONE, Length _____
- (6) Were any formations sealed against pollution?
 yes, _____ no.

If YES depth of formation 18'
Why Surface & Sand
Drillers Remarks: _____
Yield in gpm: 5
Size pump: 3/4
Type power: electric

CODED

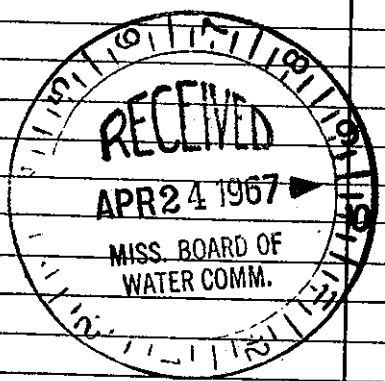

Mail this copy to Board of Water Commissioners 429 Miss. St. Jackson, Miss.