

MISSISSIPPI BOARD OF WATER COMMISSIONERS

LEE

~~2-7-63~~ P34  
2-7-63

CODED

WATER WELL DRILLERS LOG

HERNDON WELL & COMPANY CO.

Date Feb. 7, 1963, Driller: P. O. BOA County Lee

SEANNON, MISSISSIPPI

| (1) Owner of Land:   | Description & Color of Materials<br>Sand, Clay, Red Clay, Shell, etc. | Thick-<br>ness<br>Feet | Depth<br>Feet |
|--|---|------------------------|---------------|
| Continental<br>(Name) P. K. Sullivan<br>Nettleton, Miss<br>(Address)   | surface sand<br>& clay  |                        | 0             |
| (2) Location: 1/4, 1/4, Sec 19 T 115 R 7E<br>1 miles N of Nettleton<br>(distance) (direction) (Nearest Town) | Blue rock   |                        | 30            |
| (3) Topography: Flat<br>(Hilly) (Flat) (Level)   | Sand  |                        | 80            |
| (4) Purpose of Well: Domestic<br>(Domestic Irrigation<br>Municipal, Industrial, Other)                       | Bottom  |                        | 200           |


Information upon completion of well:

- (1) Diameter 5 inches.
- (2) Total Depth 200 feet.
- (3) Water Level 75 feet below top of ground.
- (4) Cased to 32', Size 5"
- (5) Screen: Size \_\_\_\_\_, Length \_\_\_\_\_
- (6) Were any formations sealed against pollution?  
 yes,  no.

If YES depth of formation 30'

Why surface & sand

Drillers Remarks:  
  
295

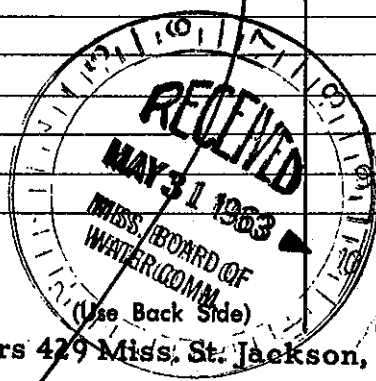

Well No.

Mail this copy to Board of Water Commissioners 429 Miss. St. Jackson, Miss