

LEE
P37
7-20-60
CODED

WATER WELL DRILLERS LOG
Herndon Well & Supply Co.
SHANNON, MISS.

P300

Date: 20 July, 1960 Driller: _____ County Lee

(Name)

		Description & Color of Materials Sand, Clay, Red Clay, Shell, etc.	Thick- ness Feet	Depth Feet
(1) Owner of Land:	<u>A. D. Coggins</u> (Name)	<u>Sand & Clay</u>		
	<u>Nuttleton Mississippi</u> (Address)	<u>Blue Gravel</u>		<u>28</u>
(2) Location:	<u>1/4, 1/4, Sec. 8 T11R7</u>	<u>Sand</u>		<u>40</u>
	<u>4 miles North of Nuttleton</u> (distance) (direction) (Nearest Town)	<u>Bottom</u>		<u>189</u>
(3) Topography:	<u>Flat</u> (Hilly) (Flat) (Level)			
(4) Purpose of Well:	<u>Home Use</u> (Domestic Irrigation Municipal, Industrial, Other)			

Information upon completion of well:


- (1) Diameter 4 inches.
- (2) Total Depth 189 feet.
- (3) Water Level 50 feet below top of ground.
- (4) Cased to 30 ft, Size 4"
- (5) Screen: Size _____, Length _____
- (6) Were any formations sealed against pollution?
X yes, _____ no.

If YES depth of formation ~~28~~ 30 ft

Why Surface

Drillers Remarks: _____

307 ?

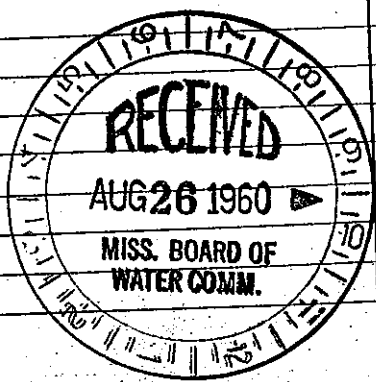

(Use Back Side)

Well No
P300

Mail this copy to Board of Water Commissioners 429 Miss. St. Jackson, Miss