

MISSISSIPPI BOARD OF WATER COMMISSIONERS

LEE
P38
5-22-61

CODED

WATER WELL DRILLERS LOG
HERNDON WELL & SUPPLY CO.

0303

LEE

Date: May 22, 1961, Driller: SHANNON P.O. BOX 42 County: HERNDON
(Name) MISSISSIPPI

	Description & Color of Materials Sand, Clay, Red Clay, Shell, etc.	Thick- ness Feet	Depth Feet
(1) Owner of Land: <u>W. R. Thron</u> (Name)	<u>Surface sand</u>		<u>0</u>
<u>Nettleton, Mississippi</u> (Address)	<u>and clay</u>		
(2) Location: <u>1/4, 1/4, Sec 19 T 11 R 7 E</u>	<u>Blue rock</u>		<u>16</u>
<u>2</u> miles <u>NE</u> of <u>Nettleton</u> (distance) (direction) (Nearest Town)	<u>Sand</u>		<u>80</u>
(3) Topography: <u>Hilly</u> (Hilly) (Flat) (Level)	<u>Bottom</u>		<u>200</u>
(4) Purpose of Well: <u>Home use</u> (Domestic Irrigation Municipal, Industrial, Other)			


Information upon completion of well:

- (1) Diameter 4 inches.
- (2) Total Depth 200 feet.
- (3) Water Level 60 feet below top of ground.
- (4) Cased to 20', Size 4"
- (5) Screen: Size , Length .
- (6) Were any formations sealed against pollution?
 yes, no.

If YES depth of formation 16

Why Just sand & sand

Drillers Remarks:

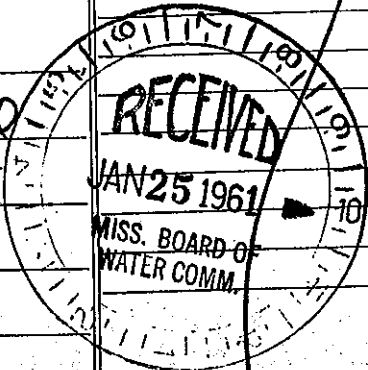

CODED

308

(Use Back Side)

Well No.

Mail this copy to Board of Water Commissioners 429 Miss. St. Jackson, Miss