

LEE
P39
6-5-61

MISSISSIPPI BOARD OF WATER COMMISSIONERS

WATER WELL DRILLERS LOG

HERNDON WELL & SUPPLY CO.

Date: June 5, 1961, Driller: HERNDON WELL & SUPPLY CO. County: Itasca
SHANNON, MISSISSIPPI

CODED

P302
Lee

(1) Owner of Land: Bessie Payne
(Name)

(Contractor) Nettleson, Mo
(Address)

(2) Location: 30 T11S7E
3 miles East of Nettleson
(distance) (direction) (Nearest Town)

(3) Topography: Flat
(Hilly) (Flat) (Level)

(4) Purpose of Well: Domestic
(Domestic Irrigation
Municipal, Industrial, Other)

Description & Color of Materials Sand, Clay, Red Clay, Shell, etc.	Thick- ness Feet	Depth Feet
<u>Surface sand</u>		0
<u>Blue sand</u>		50
<u>sand</u>		60
<u>Bottom</u>		160

Information upon completion of well:

(1) Diameter: 4 inches.

(2) Total Depth: 160 feet.

(3) Water Level: 75 feet below top of ground.

(4) Cased to: 54', Size: 4"

(5) Screen: Size: , Length:


(6) Were any formations sealed against pollution?
 yes, no.

If YES depth of formation: 50'

Why: Surface sand

Drillers Remarks:

CODED

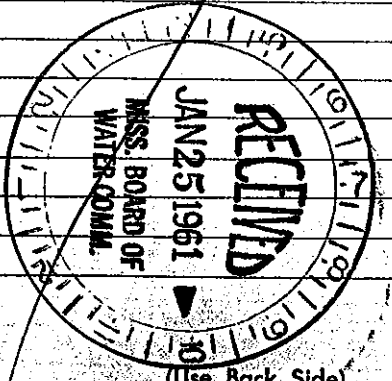

Well No. 309

Mail this copy to Board of Water Commissioners 429 Miss. St. Jackson, Miss