

MISSISSIPPI BOARD OF WATER COMMISSIONERS

LEE

P 40

6-28-61

CODED

WATER WELL DRILLERS LOG

P 301

Date Jun 28, 19 61, Driller: HERNDON WELL & SUPPLY CO. County Lee
 P. O. BOX 42
 SHANNON, MISSISSIPPI

(1) Owner of Land:	Description & Color of Materials Sand, Clay, Red Clay, Shell, etc.	Thick- ness Feet	Depth Feet
<u>Hershel Puckey</u> (Name)	<u>Surface sand</u>		<u>0</u>
<u>Hattala, Miss.</u> (Address)	<u>& clay</u>		
(2) Location: <u>21 1/4</u> Sec. <u>7</u> T. <u>15</u> R. <u>7</u> E.	<u>Blue rock</u>		<u>15</u>
<u>4</u> miles <u>NE</u> of <u>Hattala</u> (distance) (direction) (Nearest Town)	<u>sand</u>		<u>100</u>
(3) Topography: <u>Flat</u> (Hilly) (Flat) (Level)	<u>Bottom</u>		<u>200</u>
(4) Purpose of Well: <u>Domestic</u> (Domestic Irrigation Municipal, Industrial, Other)			


Information upon completion of well:

- (1) Diameter 4 inches.
- (2) Total Depth 200 feet.
- (3) Water Level 50 feet below top of ground.
- (4) Cased to 17' 4", Size 4".
- (5) Screen: Size _____, Length _____.
- (6) Were any formations sealed against pollution?
 yes, no.


If YES depth of formation 15 ft

Why Topsoil & Sand

Drillers Remarks: _____

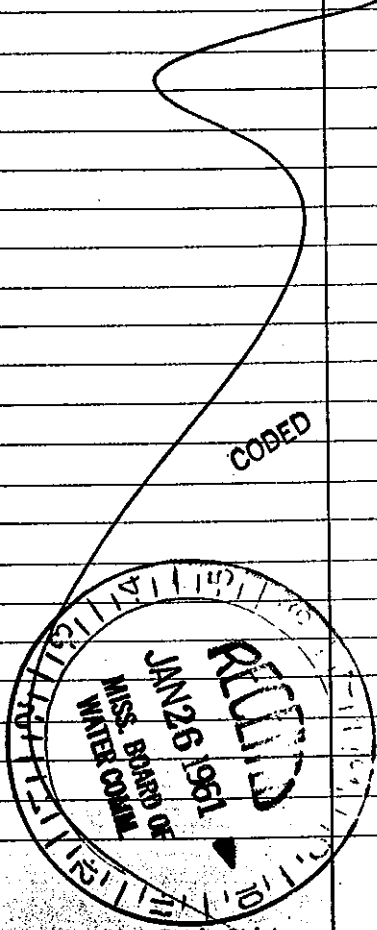

CODED

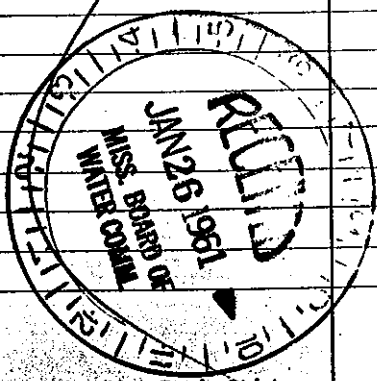

(Use Back Side)

Well No.

310

Mail this copy to Board of Water Commissioners 429 Miss. St. Jackson. Miss.