

LEE

P41

7-27-61

MISSISSIPPI BOARD OF WATER COMMISSIONERS

CODED

WATER WELL DRILLERS LOG

P312

HERNDON WELL & SUPPLY CO.

Date: 7/27, 1961, Driller: P.O. BOX 42, County: Lee, SHANNON, MISSISSIPPI

(1) Owner of Land:	Description & Color of Materials Sand, Clay, Red Clay, Shell, etc.	Thick- ness Feet	Depth Feet
Call Price (Name) Netleton, Miss. (Address)	Surface sand & clay		0
(2) Location: 1/4, 1/4, Sec. 29 T. 15 R. 7 E 2 miles East of Netleton, (distance) (direction) (Nearest Town)	Blue rock to Sand	15 to 50	
(3) Topography: Flat (Hilly) (Flat) (Level)			
(4) Purpose of Well: Domestic (Domestic Irrigation Municipal, Industrial, Other)	Bottom	173	

Information upon completion of well:


- (1) Diameter 4 inches.
- (2) Total Depth 173 feet.
- (3) Water Level 60 feet below top of ground.
- (4) Cased to 17'3", Size 4"
- (5) Screen: Size _____, Length _____
- (6) Were any formations sealed against pollution?
 yes, _____ no.

If YES depth of formation 15'

Why Surface & sand

Drillers Remarks:

(Use Back Side)

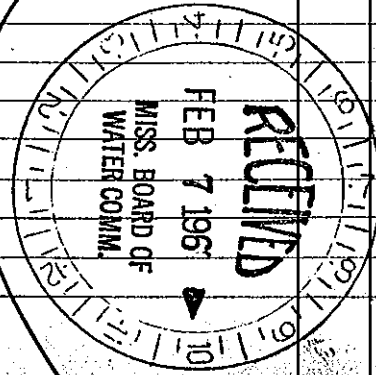

Well No.

311

Mail this copy to Board of Water Commissioners 429 Miss. St. Jackson, Miss.