

LEE
P 42
8-11-61

MISSISSIPPI BOARD OF WATER COMMISSIONERS

CODED WATER WELL DRILLERS & LOG SUPPLY CO. 7303
HERNDON WELL & SUPPLY CO.

P. O. BOX 42

Date: 8/11, 1961, Driller: SHANNON, MISSISSIPPI County: Lee
(Name)

(1) Owner of Land:	Description & Color of Materials Sand, Clay, Red Clay, Shell, etc.	Thick- ness Feet	Depth Feet
(Name) <u>John Sullivan</u> (Address) <u>Nettleton, Miss.</u>	<u>Surface sand</u> <u>& clay</u>		<u>0</u>
(2) Location: <u>29</u> ^{NS} <u>1/4</u> , <u>1/4</u> , <u>Sec 29</u> T. <u>R 7E</u> <u>1</u> miles <u>East</u> , of <u>Nettleton</u> (distance) (direction) (Nearest Town)	<u>Blue sand</u> <u>& sand</u>	<u>8</u> <u>8</u>	<u>18</u> <u>40</u>
(3) Topography: <u>Flat</u> (Hilly) (Flat) (Level)	<u>Siltstone</u>	<u>8</u>	<u>160</u>
(4) Purpose of Well: <u>Domestic</u> (Domestic Irrigation Municipal, Industrial, Other)			



Information upon completion of well:

- (1) Diameter 4 inches.
- (2) Total Depth 160 feet.
- (3) Water level 50 feet below top of ground.
- (4) Cased to 21', Size 4"
- (5) Screen: Size , Length
- (6) Were any formations sealed against pollution?
 yes, no.

If YES depth of formation 18

Why siltstone & sand

Drillers Remarks:

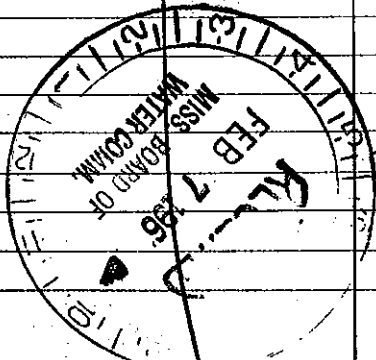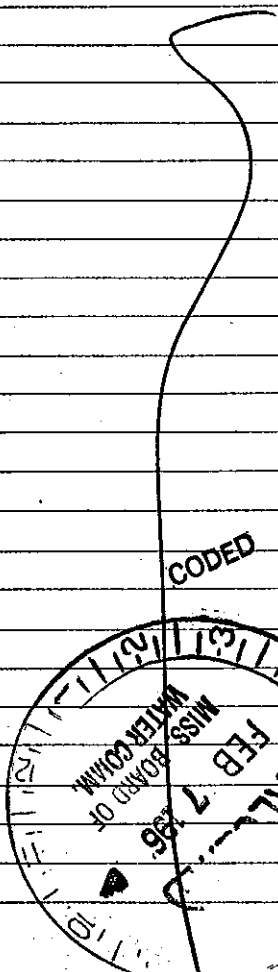

(Use Back Side)

Well No.

312