

LEE
P 43
6-8-62 CODED

MISSISSIPPI BOARD OF WATER COMMISSIONERS

WATER WELL DRILLERS LOG

HERNDON WELL & SUPPLY CO.

Date: June 8, 1962 Driller: Lee
P. O. BOX 42
SHANNON, MISSISSIPPI Lee County

(1) Owner of Land:	Description & Color of Materials Sand, Clay, Red Clay, Shell, etc.	Thick- ness Feet	Depth Feet
<u>Mrs. Kate Walton</u> (Name) <u>Nattletan, Miss.</u> (Address)	<u>Surface sand & clay</u>		<u>0</u>
(2) Location: <u>1/4, 1/4, Sec. 18 T. 11 S. R. 7 E</u> <u>1/4</u> miles <u>N E</u> of <u>Nattletan</u> (distance) (direction) (Nearest Town)	<u>Blue sand & clay</u>		<u>30</u>
(3) Topography: <u>Hilly</u> (Hilly) (Flat) (Level)	<u>sand</u>		<u>60</u>
(4) Purpose of Well: <u>Domestic</u> (Domestic Irrigation, Municipal, Industrial, Other)	<u>Bottom</u>		<u>220</u>


Information upon completion of well:

- (1) Diameter 4 inches.
- (2) Total Depth 220 feet.
- (3) Water Level 90 feet below top of ground.
- (4) Cased to 34', Size 4"
- (5) Screen: Size , Length .
- (6) Were any formations sealed against pollution?
 yes, no.

If YES depth of formation 30'
Why Surface & sand

Drillers Remarks:

316

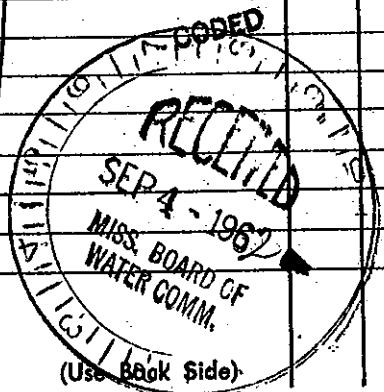

Well No.