

LEE
 P 44
 6-28-63 CODED

MISSISSIPPI BOARD OF WATER COMMISSIONERS

WATER WELL DRILLERS LOG
 HERNDON WELL & SUPPLY CO.

P. O. BOX 42

Date: Jun 25, 1963, Driller: SHANNON, MISSISSIPPI County Lee
 (Name)

	Description & Color of Materials Sand, Clay, Red Clay, Shell, etc.	Thick- ness Feet	Depth Feet
(1) Owner of Land: <u>Pet Sullivan</u> (Name) <u>Nettleton, Miss</u> (Address)	<u>surface sand</u> <u>& clay</u>		<u>0</u>
(2) Location: <u>29 115</u> T <u>7</u> R <u>7E</u> <u>1</u> miles <u>E</u> of <u>Nettleton</u> (distance) (direction) (Nearest Town)	<u>Blue sand</u> <u>&</u> <u>sand</u>	<u>20</u> <u>60</u>	
(3) Topography: <u>Flat</u> (Hilly) (Flat) (Level)	<u>&</u>		
(4) Purpose of Well: <u>Domestic</u> (Domestic Irrigation Municipal, Industrial, Other)	<u>Bottom</u>		<u>180</u>


Information upon completion of well:

- (1) Diameter 5" inches.
- (2) Total Depth 180 feet.
- (3) Water Level 70 feet below top of ground.
- (4) Cased to 23' 10", Size 5 1/2"
- (5) Screen: Size _____, Length _____
- (6) Were any formations sealed against pollution?
 yes, _____ no.

If YES depth of formation 20'

Why Surface & sand

Drillers Remarks: _____

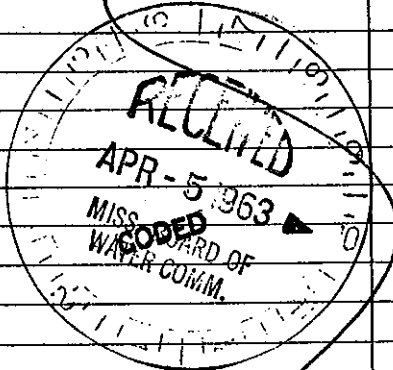

317

(Use Back Side)

Well No.